

**WAYNE**  
**T 79**  
**2-3-75**

MISSISSIPPI  
 BOARD OF WATER COMMISSIONERS  
 416 North State Street  
 Jackson, Mississippi 39201

CODED

**WATER WELL DRILLERS LOG**

Feb. 3 19 75 Haertel's Well Service Wayne  
 date well completed: firm name county well located

LANDOWNER: <u>S. S. Williams</u>	description of formations encountered	from	to
<u>Buchatunna, Rt. 1</u> <u>Miss.</u> (mailing address)			
<b>WELL LOCATION:</b> sec. <u>16</u> T <u>7</u> (N) R <u>6</u> (E) S (W) <sup>P 13 P</sup> <u>6</u> miles <u>NW</u> of <u>BUCKATONNA</u> (distance) (direction) (nearest town)	<u>topsoil</u>	<u>0</u>	<u>1</u>
	<u>layer red sand</u>	<u>1</u>	<u>13</u>
	<u>variegated sand</u>	<u>13</u>	<u>42</u>
	<u>white clay</u>	<u>42</u>	<u>120</u>
	<u>red sand</u>	<u>120</u>	<u>124</u>
	<u>white sand</u>	<u>124</u>	<u>136</u>
<b>WELL PURPOSE:</b> (home, irrigation, municipal, industrial)			
<b>WELL COMPLETION DATA:</b>			
(1) diameter (inches) <u>2"</u>			
(2) total depth (feet) <u>136 ft.</u>			
(3) static water level (feet) <u>114 ft.</u> below top of ground.			
(4) casing <u>P.V.C.</u> <u>126 ft.</u> (material) (depth)			
(size) If telescope see back.			
(5) screen <u>10 ft.</u> <u>126 ft.</u> (length) (depth to top)			
<u>2"</u> <u>P.V.C.</u> (size) (material)			
(6) pump <u>1 hp</u> <u>280 gpm</u> (HP) (yield gpm)			
<u>electric</u> (type power)			
(7) electric log <u>No</u> (yes or no)			
(organization running log)			
(8) how well bottom plugged <u>P.V.C.</u> <u>Back wash Valve</u>			
<b>DRILLERS REMARKS:</b>			


CODED

FEB 12 1975

MISS. DD. OF WATER COMMISSIONERS

If well telescopes please sketch and show depths.

GROUND LEVEL

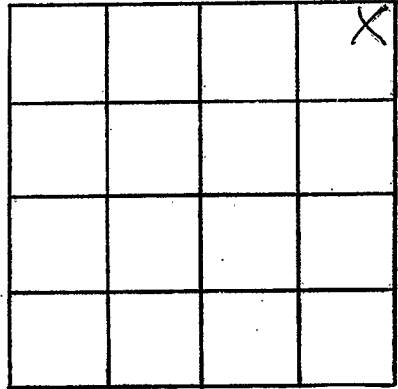

SECTION 16

Please indicate well location X.

ADDITIONAL INFORMATION

If more than one screen,  
show locations of each on sketch.