

CODED

Wayne
T 80
6-16-75

MISSISSIPPI
BOARD OF WATER COMMISSIONERS
416 North State Street
Jackson, Mississippi 39201

WATER WELL DRILLERS LOG

June 16 1975 Boate Drilling Wayne
date well completed firm name county well located

LANDOWNER: Way Mills

description of formations encountered from to

Box 4 Waynesboro Miss
(mailing address)

red clay 0 6
red sand 6 18
white sand 18 30
white clay 30 60
red to red capped sand 60 75
rest part on chalk

WELL LOCATION:
sec. 12 T 7 N R 6 E
3 miles N Bohater
(distance) (direction) (nearest town)

WELL PURPOSE: home
(home, irrigation, municipal, industrial)

5' 1 1/2" 6 slot S.S.

WELL COMPLETION DATA:

- (1) diameter (inches) 2"
- (2) total depth (feet) 75'
- (3) static water level (feet) 27' below top of ground.
- (4) casing P.V.C. 70'
(material) (depth)
2" If telescope see back.
(size)
- (5) screen 5' 70'
(length) (depth to top)
1/2" bold S.S.
(size) (material)
- (6) pump 1 12
(HP) (yield gpm)
elec.
(type power)
- (7) electric log no
(yes or no)

screwed on end of cas.
with back wash valve
on end to shell top of stone
4 2' 1" P.V.C. large pipe

(organization running log)

(8) how well bottom plugged
back wash valve


DRILLERS REMARKS:

RECEIVED
JUNE 16 1975

MISS. BD. OF WATER COMMISSIONERS

If well telescopes please sketch and show depths.

GROUND LEVEL

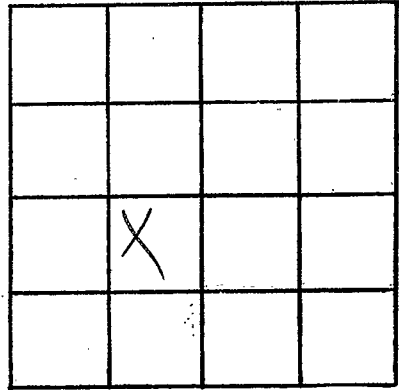

SECTION 12

Please indicate well location X.

ADDITIONAL INFORMATION

If more than one screen, show locations of each on sketch.