

MISSISSIPPI
BOARD OF WATER COMMISSIONERS
416 North State Street
Jackson, Mississippi 39201

CODED

WATER WELL DRILLERS LOG

Wayne
T 81
7-29-75
July 29 1975

Ray U West water wells wayne
firm name county well located

LANDOWNER: Mrs McCarley

Rt 1

Bucatusa Miss
(mailing address)

description of formations encountered

from to

sand	0	15
clay	15	45
sand	45	70
clay	70	120
sand	120	152

WELL LOCATION:

sec. 9 T 7 N R 6 E
4 miles NW of Bucatusa Miss
(distance) (direction) (nearest town)

WELL PURPOSE: home
(home, irrigation, municipal, industrial)

WELL COMPLETION DATA:

- (1) diameter (inches) 2
- (2) total depth (feet) 152
- (3) static water level (feet) 130 below top of ground.
- (4) casing PVC, 147 (material), (depth)

(size) if telescope see back.

- (5) screen 5, 142 (length), (depth to top)
2, St Steel (size), (material)

- (6) pump 1 1/2, 7 (HP), (yield gpm)
RCA (type power)

- (7) electric log No (yes or no)

(organization running log)


- (8) how well bottom plugged wash hole

DRILLERS REMARKS:

RECEIVED
AUG 12 1975

If well telescopes please sketch and show depths.

GROUND LEVEL

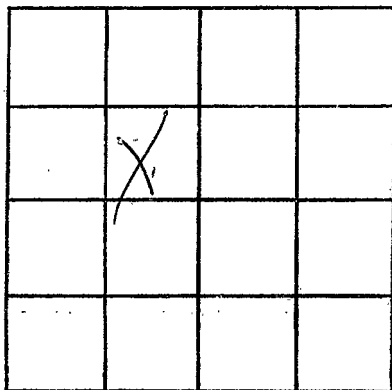

SECTION 9

Please indicate well location X.

ADDITIONAL INFORMATION

If more than one screen,
show locations of each on sketch.