

WAYNE  
T 83  
12/77  
E log #298  
Doe.

MISSISSIPPI  
BOARD OF WATER COMMISSIONERS CODED  
416 North State Street  
Jackson, Mississippi 39201  
MS GW-12785  
WATER WELL DRILLERS LOG

1977 GRINER DRILLING SERVICE WAYNE  
date well completed firm name county well located

LANDOWNER: BUCA TLWMA  
WATER ASSN. Well No. 2  
(EAST)  
(mailing address)

WELL LOCATION: N 1/2 of N 1/2 of S 1/2  
sec. 12 T 7 N R 6 E W  
miles (distance) of (direction) of (nearest town)

WELL PURPOSE:  
(home, irrigation, municipal, industrial)

- WELL COMPLETION DATA:
- (1) diameter (inches) 8 5/8
  - (2) total depth (feet) 352
  - (3) static water level (feet) 184' below top of ground.
  - (4) casing steel 216  
(material) (depth)  
8 5/8 If telescope see back.  
(size)
  - (5) screen 46.40' 305.60 ft.  
(length) (depth to top)  
6 7/8" 304 S.S. SCREEN  
(size) (material)  
(.008 - 10.45 ft. on top)  
(.010 - 35.90 ft. on bottom)  
(46.40 total screen)
  - (6) pump 95 924  
(HP) (yield gpm)  
Elect  
(type power)
  - (7) electric log Yes  
(yes or no)  
MISS. Geol. SURVEY  
(organization running log)
  - (8) how well bottom plugged BACK  
WASH VALVE

description of formations encountered	from	to
TOP SOIL	0	3
CLAY	3	10
SAND + CLAY STREAKS	10	90
CLAY	90	190
SAND, COARSE	190	210
CLAY	210	246
CLAY + ROCKS	246	312
SAND, MEDIUM	312	355
CLAY	355	390
SAND + CLAY STREAKS	390	425
CLAY + ROCKS (HARD)	425	712


RECEIVED  
JAN 25 1978

MISS. Bd. OF WATER COMMISSIONERS

DRILLERS REMARKS:

If well telescopes please sketch and show depths.

GROUND LEVEL

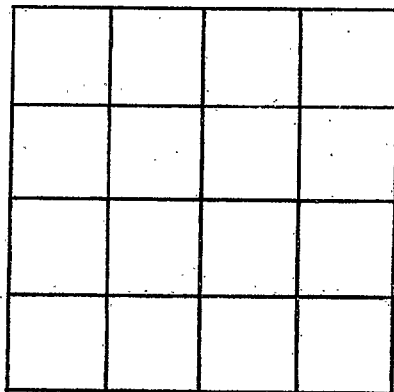

SECTION \_\_\_\_\_

Please indicate well location X.

ADDITIONAL INFORMATION

If more than one screen, show locations of each on sketch.