

MISSISSIPPI DEPARTMENT OF NATURAL RESOURCES

Bureau of Land and Water Resources

Southport Mall

P.O. Box 10631

Jackson, Mississippi 39209

WATER WELL DRILLERS LOG

CODED

WAYNE  
T87  
10-9-85

Oct 9 1985 date well completed      R.S. Co. Drilling & Log firm name      Wayne county well located

LANDOWNER: George Clark  
Alt 1 Bushatan, Mo.  
(mailing address)

WELL LOCATION:  
sec 23 T 7 N R 6 E  
1 1/2 miles NW of Bushatan  
(distance) (direction) (nearest town)

WELL PURPOSE: drinking water  
(home, irrigation, municipal, industrial)

WELL COMPLETION DATA:

- (1) diameter (inches) 2'
- (2) total depth (feet) 642
- (3) static water level (feet) 20' below top of ground. above
- (4) casing galvanized (material) 604 (depth)  
2' if telescope see back. (size)
- (5) screen none used (length) (depth to top)  
(size) (material)
- (6) pump none used (HP) none used (yield gpm)  
25 gal flow (type power)
- (7) electric log (yes or no)
- (organization running log)
- (8) how well bottom plugged regular

description of formations encountered	from	to
sand & clay	0	27
clay	27	45
sand	45	50
clay	50	65
sand & clay with soft	65	130
sand & lignite	130	140
clay	140	157
sand	157	170
clay	170	177
sand & clay	177	202
clay	202	232
thin bedded sand	232	250
clay	250	259
sand & lignite	259	302
sand	302	307
clay	307	322
limestone rock	322	392
white clay some rock	392	427
blue clay	427	450
rock struffs	450	522
clay	522	572
shaly rock	572	604
concrete sand	604	618
rock	618	620
sand - coarse rock	620	622
rock	622	629
sand some clay	629	634
rock	634	635
sand some clay	635	642
shel in sand & clay		

RECEIVED


NOV 22 1985

DRILLERS REMARKS:  
3 1/2' casing set into  
rock at 604'

Department of Natural Resources  
Bureau of Land & Water Resources

If well telescopes please sketch and show depths.

GROUND LEVEL

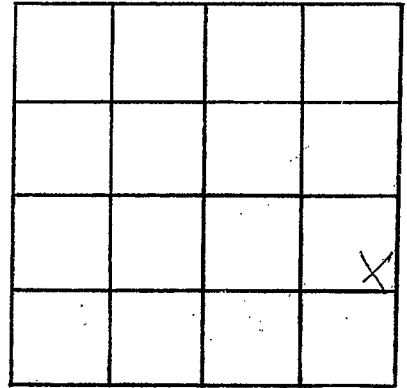

SECTION 23

Please indicate well location X.

ADDITIONAL INFORMATION

If more than one screen,  
show locations of each on sketch.