
well #	2.	
County: <u>ERP</u> Permit #: <u>5496</u> Driller: <u>ERP mosetay</u> Date drilling completed: <u>5-12-15</u> State Law requires that this report	State Well Report         Part 1 – Driller's Log         Mississippi Department of Environmental Quality         Office of Land and Water Resources         P.O. Box 2309         Jackson, MS 39225         (601)961- 5210         (601)961- 5228 (fax)         be prepared by the license holder responsible for         within 30 days of completion of drilling of the well         wner       Well or B         a water well)       Latitude: 31 • 33 • 38         Method of Lat/Long (circle or	I or borehole. orehole Location & Longitude: <u>85% 32, 572</u> ne): Conventional Survey,
City State	$\frac{m_{1}}{5} \frac{57}{37} \frac{37}{22}$ $\frac{m_{1}}{5} \frac{5}{5} \frac{5}{4} \frac{5}{5} \frac{24}{5}$ $\frac{5}{5} \frac{1}{5} \frac{5}{5} \frac{1}{5} \frac{5}{5} \frac{24}{5}$ $\frac{1}{5} \frac{1}{5} $	1 GP8, Survey-grade GPS
Location of the source of any surface water Method of dosing and volume of Chlorine Logs run (circle all applicable): No log run Name of organization running log(s): Purpose of borehole (check one): Water We	ling completed: $5 - 12 - 15$ Hole depth: $88'$ used for drilling: $837 - 20077 + 2042 - 20077 + 20000 + 20000 + 2$	DenHAN RN Per 1000 Other: d Source Heat Pump RECEIVE
	urveyOther ( <i>describe</i> ) o water well construction, skip the remainder of this bl dustrial Public Supply Irrigation Fish Culture : Valve Other (describe)	Other: AG BY: OLWF
Static Water Level: $\underline{/7}'$ feet abo Method of Measurement (circle one) stee Well depth: $\underline{88}'$ Well grouted to a dept	th of $\frac{10}{2}$ feet Type of grout (circle one). Neat Central Stress S	5-12-15 ment Bentonite Mix
Screen length: $\frac{10}{44000000000000000000000000000000000$	n diameter:inches Type of cusing Setting depth: FromSfeet toS Gravel packed Underreamed Telescoped Open Other (describe):	PI-C - 8 feet hole Natural Development
	feet. If telescoped or more than one scre	

د ۱

Form: OLWR-SWR-1A (04/08)

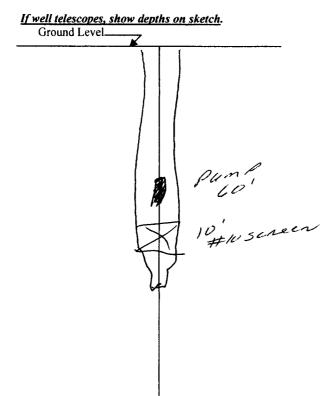

neus una obrenotes, amess specificany	caterior i ega	
		<b>N</b>
Description of Formations Encountered	From (depth)	To (depth)
TOP SPIL	Ground Level	1
BRUWN CIAI	/	13
BRUWN CIAN CUARSE USSAND	13	28
GRAV CLAY	25	55
FISAND	55	65
men/sang	65	88
		1
	1	1
	1	1
L		1

<u>Description of formations encountered must be provided for an</u> wells and boreholes, unless specifically exempted by regulations

If more than one screen, show location of each on sketch

Sketch the property layout and include the following: 1) the well location; 2) any permanent structures on the property that may aid in locating the well; 3) any roads, power lines, or other items that may aid in locating the property and the well; HWY 45 SOUTH TO BUCKATUMA TURN RION BECRA AT CHEVRON GO IMITE TO DINTRO. ON RT GO LAST 6 CHicken House ALL LEWERK Landowner Name: Form: OLWR-SWR-1A (04/08)

I certify that the well/borehole was drilled, constructed, and completed in accordance with all applicable requirements of the Mississippi Department of Environmental Quality and the Mississippi Department of Health regulations, if applicable, and state laws.

!	STATE WI	ELL REPORT		
0 1	P	art 2	For Office Use Only:	
County: UAYne		Pump Installer's Completion Report		
Permit #: <u>5494</u>	Mississippi Departmen	t of Environmental Quality	Aquifer:	
	Office of Land a	and Water Resources		[
Driller: EARL MUSER	P.O.	P.O. Box 2309		
Date completed: 5-19-15	Jacksor	, MS 39225	Well #: 101	
Date completed		961-5210	Elevation:	
Copy information from block on Par	<u>t 1</u> (601)96	1-5228 (fax)		
This part of the report must be correspondent to the report must be attached and both	ompleted by a licensed water well parts filed with the Department of	contractor or a licensed pump at the above address within 30	p installer. A copy of Part I of the days of well completion.	
report must be attached and both parts filed with the Department of Well Owner Information		N N	ell Location	
Dwner Name: <u>SHANE</u>		Latitude: 31- 33-32	38 Longitude: <u>088 32 . :</u>	512
Mailing Address: <u>OID Hwy 45</u>		Method of Lat/Long (check	one): Conventional Survey,	
	·	-	eld GPSSurvey-grade GPS	-
Bucka Trans M5 39322 City State Zip Code			24 T72 R 6a	
•		Distance Direction	Nearest Town	ļ
Telephone No. ()	4	Miles	of BuckATANNA	-
Pump	Туре		Power Type	
	e one		Circle one	
Air Lift Jet	Submersible	Diesel Engine Gase	oline Engine Natural Gas	
Bucket Piston	Turbine	Electric Motor Har		
Centrifugal Rotary	Flowing Well		er (specify):	
Other (specify):		Horse Power Rating of Mo	tor:	استعلالا الاعتماد
Date Pump Installed: <u>5-19</u>	-15	Setting Depth:	p feet REC	
Rated Pump Capacity: 35	Gallons Per Minute	Number of Stages:	,IUN	1 5 2015
Pump	Fest Data	Method of	Measuring Water Level	OW
Date Well Tested: <u>5-/5-</u>	15	Air Line Electric N	Circle one Measuring Line Steel Tape	
Static Water Level (A):				
Pumping Water Level (B):				
Drawdown [(B) – (A)]: $//_$		-	d shut in head:feet	
Test Pumping Rate: <u>48</u>	Gallons Per Minute	wen yielded	GPM with a drawdown of	
Duration of Pump Test (minimur	n 4 hours):hours	feet afte	erhours of pumping	g
		-f		
I HEREBY CERTIFY that the a	bove statements are true to the best	of my knowledge.		1
I HEREBY CERTIFY that the a	bove statements are true to the best	Signature of Pum		

۶

۹.