

Wayne
T 200
11/1/75

MISSISSIPPI
BOARD OF WATER COMMISSIONERS
416 North State Street
Jackson, Mississippi 39201

WATER WELL DRILLERS LOG

Nov 1 1975 Porter Drilling & Log 24 miles
date well completed firm name county well located

LANDOWNER: Kelly Ross
P.O. Box 335
Claymesboro Miss.
(mailing address)

WELL LOCATION:
sec. 14 T 7 N R 6 E 13P
3 miles NW of Puckett
(distance) (direction) (nearest town)

WELL PURPOSE: farm
(home, irrigation, municipal, industrial)

WELL COMPLETION DATA:
(1) diameter (inches) 2"
(2) total depth (feet) 246
(3) static water level (feet) below above top of ground.
(4) casing P.V.C. 241'
(material) (depth)
2' if telescope see back.
(size)
(5) screen 5' 241'
(length) (depth/to top)
1 1/2' basket S.S.
(size) (material)
(6) pump none 12
(HP) (yield, gpm)
flow
(type power)
(7) electric log (yes or no)
(organization running log)

description of formations encountered	from	to
Clay & sand	0	20
middle sand	20	64
Clay & sand	64	69
Clay	69	85
Clay & sand	85	100
sand	100	129
Clay	129	135
sand	135	150
Clay	150	165
sand & clay	165	170
sand	170	187
clay & sand	187	202
Clay	202	207
rock strata	207	222
sand & clay	222	235
clean sand strata stop on chalk	235	260

(8) how well bottom plugged
back wash valve

DRILLERS REMARKS:


5' 1/2" 6 slot S.S.
screen removed on end
of case with back
wash valve on end
& steel logs above

DEC - 1 1975

MISS. Bd. OF WATER COMMISSIONERS

If well telescopes please sketch and show depths.

GROUND LEVEL

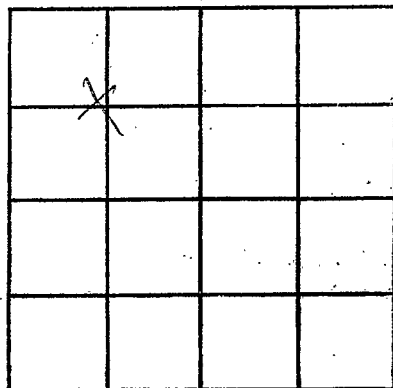

SECTION 14

Please indicate well location X.

ADDITIONAL INFORMATION

If more than one screen,
show locations of each on sketch.