

Wayne
T 220
11/12/75

MISSISSIPPI
BOARD OF WATER COMMISSIONERS
416 North State Street
Jackson, Mississippi 39201

WATER WELL DRILLERS LOG

Nov. 12 1975 Robt. Drilling, Inc. Wayne
date well completed firm name county well located

LANDOWNER: <u>Kenneth Deal</u>	description of formations encountered	from	to
<u>Plot 1</u>			
<u>Buckatunna Miss</u> (mailing address)	<u>Clay</u>	<u>0</u>	<u>4</u>
	<u>sand</u>	<u>4</u>	<u>27</u>
	<u>Clay</u>	<u>27</u>	<u>75</u>
	<u>sand</u>	<u>75</u>	<u>79</u>
	<u>Clay</u>	<u>79</u>	<u>90</u>
	<u>sand</u>	<u>90</u>	<u>120</u>
	<u>Clay</u>	<u>120</u>	<u>132</u>
	<u>sand & clay</u>	<u>132</u>	<u>165</u>
	<u>Clay & sand</u>	<u>165</u>	<u>197</u>
	<u>Clay</u>	<u>197</u>	<u>210</u>
	<u>med fine sand</u>	<u>210</u>	<u>242</u>
WELL LOCATION: sec <u>14</u> T <u>70</u> N R <u>6</u> E S W <u>3</u> miles NW of <u>Buckatunna</u> (distance) (direction) (nearest town) ^{13P}			
WELL PURPOSE: <u>home</u> (home, irrigation, municipal, industrial)			
WELL COMPLETION DATA:			
(1) diameter (inches) <u>2"</u>			
(2) total depth (feet) <u>242'</u>			
(3) static water level (feet) <u>13'</u> ^{below} _{above} top of ground.			
(4) casing <u>P.V.C.</u> , <u>237'</u> (material) (depth) <u>2'</u> if telescope see back. (size)			
(5) screen <u>5'</u> , <u>237'</u> (length) (depth to top) <u>1-1/4"</u> , <u>60 lb S&S</u> (size) (material)			
(6) pump <u>1/2</u> , <u>10</u> (HP) (yield gpm) <u>elec.</u> (type power)			
(7) electric log <u>no</u> (yes or no)			
(organization running log)			
(8) how well bottom plugged <u>back wash valve</u>			
DRILLERS REMARKS:			

5' 1-1/2" 6 slt S.S.
screwed on end of
case with back wash
valve on end & shell
trays above.
no drop pipe


RECEIVED
RECEIVED

DEC 4 1975

MISS BR WATER COMM

If well telescopes please sketch and show depths.

GROUND LEVEL

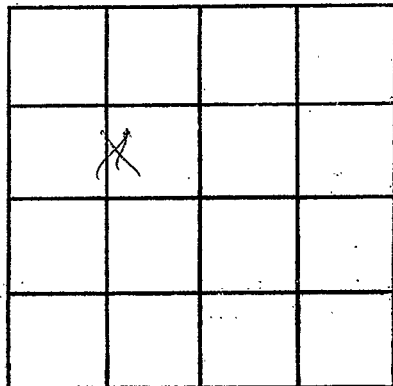

SECTION 14

Please indicate well location X.

ADDITIONAL INFORMATION

If more than one screen, show locations of each on sketch.