

WAYNE  
T 3002  
12-12-75

MISSISSIPPI  
 BOARD OF WATER COMMISSIONERS  
 416 North State Street  
 Jackson, Mississippi 39201

WATER WELL DRILLERS LOG

Dec 12 1975 Post Drilling & Log Wayne  
 date well completed firm name county well located

LANDOWNER: Maethe White  
At 4 Waynesboro Miss  
 (mailing address)

description of formations encountered	from	to
<u>Clay</u>	<u>0</u>	<u>8</u>
<u>2 in - 1 1/2 in gravel</u>	<u>8</u>	<u>32</u>
<u>shaly clay</u>		

WELL LOCATION:  
 sec. 11 T. 7 N. R. 6 E.  
32 miles NW of Prichard  
 (distance) (direction) (nearest town)

WELL PURPOSE: Home  
 (home, irrigation, municipal, industrial)

- WELL COMPLETION DATA:
- (1) diameter (inches) 2 1/2" 2"
  - (2) total depth (feet) 32'
  - (3) static water level (feet) 7 (below/above top of ground)
  - (4) casing PVC 27'  
 (material) (depth)  
2' If telescope see back.  
 (size)
  - (5) screen 5' 27'  
 (length) (depth to top)  
1/4" galv. S.S.  
 (size) (material)
  - (6) pump 3/4 15  
 (HP) (yield gpm)  
elec  
 (type power)
  - (7) electric log yes  
 (yes or no)
- (organization running log)


(8) how well bottom plugged  
back and water

DRILLERS REMARKS:

**RECEIVED**  
 FEB 18 1976

If well telescopes please sketch and show depths.

GROUND LEVEL

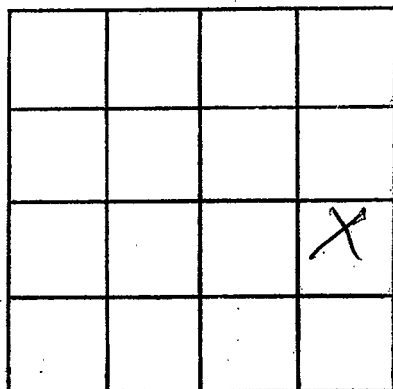

SECTION 11

Please indicate well location X.

ADDITIONAL INFORMATION

If more than one screen,  
show locations of each on sketch.