

WAYNE
 T 2004
 1-31-76

MISSISSIPPI
 BOARD OF WATER COMMISSIONERS
 416 North State Street
 Jackson, Mississippi 39201

WATER WELL DRILLERS LOG


McILWAIN WATER WELL SERVICE WAYNE

JAN 31, 1976
 date well completed

RI. 72 BOX 37
 WAYNESBORO MISS 39367

county well located

LANDOWNER:	description of formations encountered	from	to
ARGIE SMITH			
WAYNESBORO, MISS. (mailing address)	Sand + Clay	5	10
WELL LOCATION: sec. 14 T 7 N R 6 W 8 miles SE of W'BORO (distance) (direction) (nearest town)	Coarse Sand	10	18
WELL PURPOSE: HOME (home, irrigation, municipal, industrial)			
WELL COMPLETION DATA:			
(1) diameter (inches) 2"			
(2) total depth (feet) 18'			
(3) static water level (feet) 9 1/2' below top of ground.			
(4) casing PVC 14' (material) (depth) 2" (size) If telescope see back.			
(5) screen 4' 14' (length) (depth to top) 2" (size) PVC (material)			
(6) pump 1/3 6 (HP) (yield gpm) 110 AC (type power)			
(7) electric log no (yes or no)			
(organization running log)			
(8) how well bottom plugged			

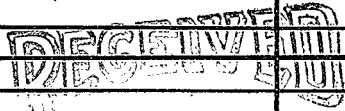


MAR 11 1976

DRILLERS REMARKS:

If well telescopes please sketch and show depths.

GROUND LEVEL

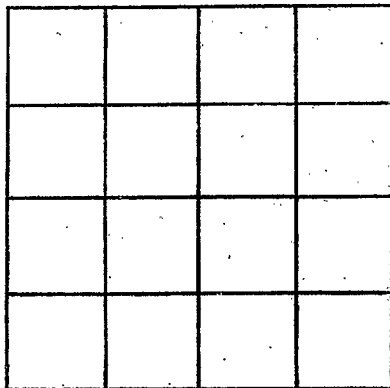

SECTION _____

Please indicate well location X.

ADDITIONAL INFORMATION

If more than one screen, show locations of each on sketch.