

Wayne  
T 2005  
4-23-76

MISSISSIPPI  
BOARD OF WATER COMMISSIONERS  
416 North State Street  
13P Jackson, Mississippi 39201

WATER WELL DRILLERS LOG

April 23 1976 date well completed  
Porter Drilling & Log firm name  
Wayne county well located

LANDOWNER: Henry Daley  
Attn: Roy GSA  
Ruckatenna Miss.  
(mailing address)

WELL LOCATION:  
sec 22 T 7 N R 6 E  
3 miles W of Ruckatenna  
(distance) (direction) (nearest town)

WELL PURPOSE: Home  
(home, irrigation, municipal, industrial)

WELL COMPLETION DATA:  
(1) diameter (inches) 2"  
(2) total depth (feet) 120"  
(3) static water level (feet) 79 below above top of ground.  
(4) casing P.V.C. 1 1/2" (material) (depth) 2" (size) If telescope see back.  
(5) screen 5' 1 1/2" (length) (depth to top) 1/4" bolt S.S. (size) (material)  
(6) pump 1 (HP) 6 (yield gpm)  
elec. (type power)  
(7) electric log no (yes or no)  
(organization running log)

(8) how well bottom plugged  
back wash valve


DRILLERS REMARKS:

description of formations encountered	from	to
clay	0	43
shaly rock		43
clay	43	44
shaly rock		44
clay	44	96
shaly rock		96
clay	96	99
fine sand & clay	99	107
clay	107	120
shaly rock	107	120
shaly rock		
5' 1 1/2" bolts screened on end of casing with back wash valve on end & shell lag above		
9.5' 1" P.V.C. casing pipe		

DEPT. OF WATER CONTROL  
MAY 24 1976  
MISS. BO. OF WATER CONTROL

If well telescopes please sketch and show depths.

GROUND LEVEL

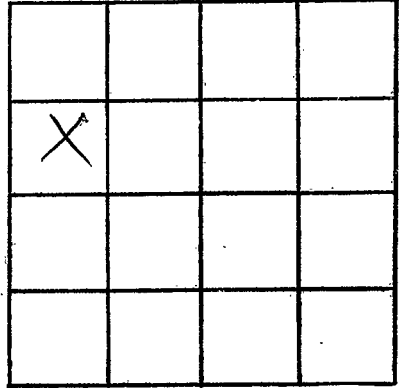

SECTION 22

Please indicate well location X.

ADDITIONAL INFORMATION

If more than one screen,  
show locations of each on sketch.