


WAYNE
T
4-28-76

MISSISSIPPI
BOARD OF WATER COMMISSIONERS
416 North State Street
Jackson, Mississippi 39201

WATER WELL DRILLERS LOG

April 28 1976 *Porter Drilling & Log* Wayne
date well completed firm name county well located

LANDOWNER: <i>Jerry Hutto</i>	description of formations encountered	from	to
<i>At 1 Buckatanna Miss</i> (mailing address)	Clay	0	62
	sand & clay	62	67
	Clay	67	120
	hard fine sand	120	124
	Clay	124	171
	sand thru to meet		
	at bottom	171	200
	strat white shell		
	in sand		
	5' 1 1/4" hole S.S.		
	screwed on end of casing		
	will back wash valve		
	on end to shell large		
	above		
	106' 1" PVC down		
	pipe		

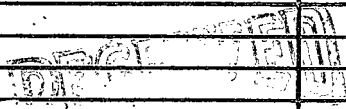

MAY 21 1976

OF WATER

If well telescopes please sketch and show depths.

GROUND LEVEL

X			

SECTION 27

Please indicate well location X.

ADDITIONAL INFORMATION

If more than one screen, show locations of each on sketch.