

Wayne
 T 2007
 S-24-76

MISSISSIPPI
 BOARD OF WATER COMMISSIONERS
 416 North State Street
 13P Jackson, Mississippi 39201

WATER WELL DRILLERS LOG

May 24, 1976
 date well completed

McILWAIN WATER WELL SERVICE

Wayne

RI firm, name BOX 37
 MISSISSIPPO, MISS. 39366

county well located

LANDOWNER:
 Jerry Williams
 Waynesboro, Miss.
 (mailing address)

description of formations encountered	from	to
Red Clay	0	15
Red Sand	15	35
Sand + some Clay	35	54
Clay	54	66
Sand	66	71
Clay	71	73
Sand	73	77
Hard Clay	77	95
Sand	95	104

WELL LOCATION:
 sec. 1 T 7 N R 6 E
 10 miles SE of W'BOBO
 (distance) (direction) (nearest town)

WELL PURPOSE: Home
 (home, irrigation, municipal, industrial)


- WELL COMPLETION DATA:
- (1) diameter (inches) 2"
 - (2) total depth (feet) 104'
 - (3) static water level (feet) 83' below top of ground
 - (4) casing PVC 100' (material) (depth)
 2" (size) If telescope see back.
 - (5) screen 4' 100' (length) (depth to top)
 2" (size) PVC (material)
 - (6) pump 1 6 (HP) (yield gpm)
 220 AC (type power)
 - (7) electric log NO (yes or no)
 - (8) how well bottom plugged _____

DRILLERS REMARKS:

MAY 24 1976

If well telescopes please
sketch and show depths.

GROUND LEVEL

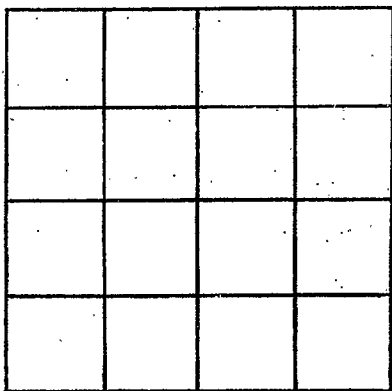

SECTION _____

Please indicate well location X.

ADDITIONAL INFORMATION

If more than one screen,
show locations of each on sketch.