

WAYNE  
T 2008  
5-25-76

MISSISSIPPI  
BOARD OF WATER COMMISSIONERS  
416 North State Street  
Jackson, Mississippi 39201

WATER WELL DRILLERS LOG

May 25, 1976  
date well completed

McILWAIN WATER WELL SERVICE  
RT firm name  
Wayne  
county well located

13P

WAYNESBORO, MISS. 39090

LANDOWNER:  
Cassie B. Gray  
Waynesboro, Miss  
(mailing address)

description of formations encountered	from	to
Red Clay	0	10
Red Sand	10	20
Coarse sand	20	27
Clay	27	45
Sand	45	48
clay	48	55
Sand	55	62
Clay	62	82
Sand	82	86
Hard Clay	86	95
Fine Sand + Clay	95	135
Sand + Clay	135	145
Sand	145	153

WELL LOCATION:  
sec. 1 T 7 N R. 4 E  
10 miles SE of W'BORO  
(distance) (direction) (nearest town)


WELL PURPOSE: Home  
(home, irrigation, municipal, industrial)

- WELL COMPLETION DATA:
- (1) diameter (inches) 2"
  - (2) total depth (feet) 153
  - (3) static water level (feet) 92' below top of ground
  - (4) casing PVC 149' (material) (depth)  
2" (size) if telescope see back.
  - (5) screen 4' 149' (length) (depth to top)  
2" (size) PVC (material)
  - (6) pump 1 (HP) 5 (yield gpm)  
110 AC (type power)
  - (7) electric log no (yes or no)

(organization running log)

(8) how well bottom plugged

DRILLERS REMARKS:

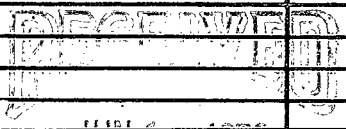


JUN 18 1976

MISS. RD. REG. STATE CHIEF

If well telescopes please sketch and show depths.

GROUND LEVEL

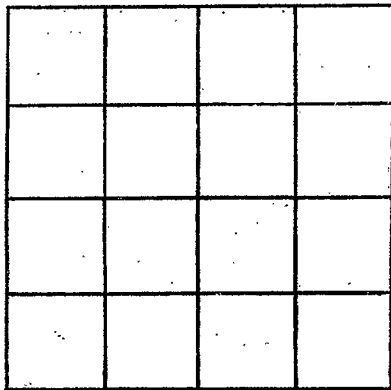

SECTION \_\_\_\_\_

Please indicate well location X.

ADDITIONAL INFORMATION

If more than one screen, show locations of each on sketch.