

Wayne  
T 2010  
6-29-76

MISSISSIPPI  
BOARD OF WATER COMMISSIONERS  
416 North State Street  
Jackson, Mississippi 39201

WATER WELL DRILLERS LOG

McILWAIN WATER WELL SERVICE

Wayne

June 29, 1976<sup>13P</sup>  
date well completed

RT. from name BOX 31  
WAYNESBORO, MISS. 39367

county well located


LANDOWNER:	description of formations encountered	from	to
Bill Mercer Waynesboro, Miss. (mailing address)			
WELL LOCATION:	Red Clay	0	10
sec. 35 T 7 N R 6 E 3 miles W of Ducaturva (distance) (direction) (nearest town)	Sand & clay	10	18
WELL PURPOSE: Home (home, irrigation, municipal, industrial)	Yellow Clay	18	22
WELL COMPLETION DATA:	Gray Clay	22	35
(1) diameter (inches) 2"	Sand & clay	35	43
(2) total depth (feet) 82'	Clay	43	55
(3) static water level (feet) 69' below top of ground.	Fine Sand	55	58
(4) casing PVC 78' (material) (depth)	Clay	58	75
2" (size) if telescope see back.	Fine Sand	75	77
(5) screen 4' 78' (length) (depth to top)	Med Sand	77	82
2" (size) PVC (material)			
(6) pump Pump not installed (HP) (yield gpm)			
(type power)			
(7) electric log (yes or no)			
(organization running log)			
(8) how well bottom plugged			
DRILLERS REMARKS:			

RECEIVED  
JUL 14 1976

MISS. BD. OF WATER COMMISSIONERS

If well telescopes please sketch and show depths.

GROUND LEVEL

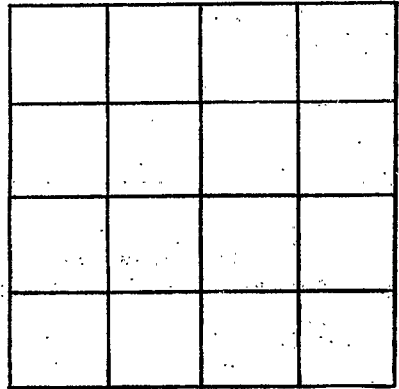

SECTION \_\_\_\_\_

Please indicate well location X.

ADDITIONAL INFORMATION

If more than one screen, show locations of each on sketch.