

WAYNE
T 2012
10/4/76

MISSISSIPPI
BOARD OF WATER COMMISSIONERS
416 North State Street
Jackson, Mississippi 39201

13P

WATER WELL DRILLERS LOG

Oct 4 1976 Porter Drilling & Pipe Co Wayne
date well completed firm name county well located

LANDOWNER: Neil West description of formations encountered from to

At 3 1/2 miles from
(mailing address)

WELL LOCATION:
sec 30 T 7 N R 6 E
S (W)
4 miles SE of Claron
(distance) (direction) (nearest town)

WELL PURPOSE: home
(home, irrigation, municipal, industrial)

WELL COMPLETION DATA:

- (1) diameter (inches) 2"
- (2) total depth (feet) 64
- (3) static water level (feet) 33 (below/above top of ground)
- (4) casing PVC 60'
(material) (depth)
2" if telescope see back.
(size)
- (5) screen 4' 60'
(length) (depth to top)
2" slat S.S.
(size) (material)
- (6) pump 1 10
(HP) (yield gpm)
elec
(type power)
- (7) electric log none
(yes or no)

(organization running log)

(8) how well bottom plugged 2" backwash valve

DRILLERS REMARKS:


Clay 0 20
sand & clay 20 45
slat S.S. 45 64
slat on clay & sand 64 64
4" 2" 7 slat S.S. well
2" back wash valve on
end & slat trap above
50' 1" P.V.C. drop pipe

RECEIVED
NOV - 3 1976

MISS. Bd. OF WATER COMMISSIONERS

If well telescopes please sketch and show depths.

GROUND LEVEL

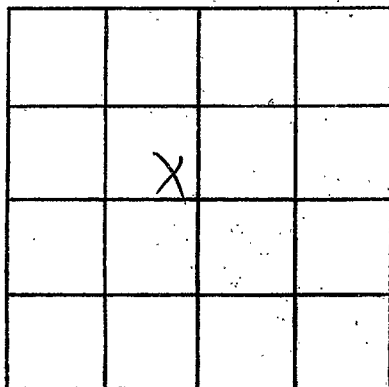

SECTION 30

Please indicate well location X.

ADDITIONAL INFORMATION

If more than one screen, show locations of each on sketch.