

Wayne
T 2013
10/19/76

MISSISSIPPI
BOARD OF WATER COMMISSIONERS
416 North State Street
Jackson, Mississippi 39201

WATER WELL DRILLERS LOG

Oct 19 1976 ^{13P} Carter Drilling & Log. Wayne
date well completed firm name county well located

LANDOWNER: Harold Loffaker
At 32 Haynesboro, Miss
(mailing address)

WELL LOCATION:
sec. 19 T 7 N R 6 E
3 miles SE of Clara
(distance) (direction) (nearest town)

WELL PURPOSE: home
(home, irrigation, municipal, industrial)

WELL COMPLETION DATA:
(1) diameter (inches) 4
(2) total depth (feet) 267
(3) static water level (feet) 115 below top of ground.
(4) casing PVC 259'
(material) (depth)
4" if telescope see back.
(size)
(5) screen 8' 259'
(length) (depth to top)
2" 7alt. S.S.
(size) (material)
(6) pump 3/4 10
(HP) (yield gpm)
elec.
(type power)
(7) electric log no
(yes or no)
(organization running log)
(8) how well bottom plugged
1/2" backwash valve


description of formations encountered	from	to
sand & clay	0	25
clay	25	222
fine sand	222	240
clay & sand	240	251
clay	251	255
med. coarse sand	255	270
stratified white shell in sand		
8' 2" 7alt. S.S. screen		
screened on end of casing		
with shell trap above		
& 1 1/4" backwash valve on end		
147' 1" steel drop pipe		

RECEIVED
NOV - 8 1976

DRILLERS REMARKS:

If well telescopes please sketch and show depths.

GROUND LEVEL

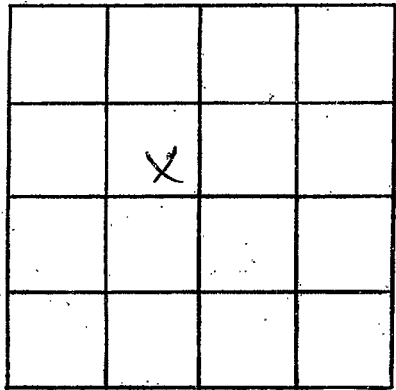

SECTION 19

Please indicate well location X.

ADDITIONAL INFORMATION

If more than one screen,
show locations of each on sketch.