

Wayne
T 2014
11/23/76

MISSISSIPPI
BOARD OF WATER COMMISSIONERS
416 North State Street
Jackson, Mississippi 39201

WATER WELL DRILLERS LOG

Nov 23 1976 *Porter Drilling & Log* Wayne
date well completed firm name county well located


LANDOWNER:	description of formations encountered	from	to
<i>Eluna Harris</i>	<i>rest clay + sand</i>	<i>0</i>	<i>15</i>
<i>Box 4 Maurelboro</i> (mailing address)	<i>clay</i>	<i>15</i>	<i>70</i>
WELL LOCATION: sec. <i>13</i> T <i>7</i> N R <i>6</i> E <i>3</i> miles N <i>Buckhorn</i> of <i>W</i> (distance) (direction) (nearest town)	<i>sand</i>	<i>70</i>	<i>80</i>
WELL PURPOSE: (home, irrigation, municipal, industrial)	<i>clay</i>	<i>80</i>	<i>96</i>
WELL COMPLETION DATA: (1) diameter (inches) <i>2"</i>	<i>sand</i>	<i>96</i>	<i>109</i>
(2) total depth (feet) <i>109'</i>	<i>strat on soft</i>		
(3) static water level (feet) <i>63</i> (below/above top of ground)	<i>shaly sand</i>		
(4) casing <i>P.V.C.</i> <i>105'</i> (material) (depth)			
<i>2"</i> (size) If telescope see back:	<i>4' 1/4" hole SS screen</i>		
(5) screen <i>4'</i> <i>105'</i> (length) (depth to top)	<i>screened on end of</i>		
<i>1 1/4"</i> (size) <i>cast S.S.</i> (material)	<i>cas with shell large</i>		
(6) pump <i>3/4</i> <i>6</i> (HP) (yield gpm)	<i>above + back wash</i>		
<i>elec.</i> (type power)	<i>water on end</i>		
(7) electric log <i>no</i> (yes or no)	<i>82' 1" P.V.C. pipe</i>		
(organization running log)	<i>pipe</i>		
(8) how well bottom plugged <i>back wash valve</i>			
DRILLERS REMARKS:			

RECEIVED
DEC 6 1976

MISS. BD. OF WATER COMMISSIONERS

If well telescopes please sketch and show depths.

GROUND LEVEL

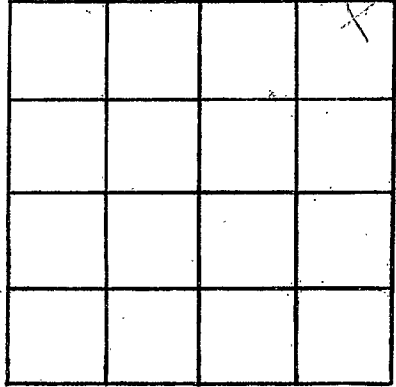

SECTION 13

Please indicate well location X.

ADDITIONAL INFORMATION

If more than one screen, show locations of each on sketch.