

WAYNE
T 2015
11/27/76

MISSISSIPPI
BOARD OF WATER COMMISSIONERS
416 North State Street
Jackson, Mississippi 39201

WATER WELL DRILLERS LOG

11-27 1976 CARRS well service Wayne
date well completed firm name county well located

LANDOWNER: <u>Edward Powe</u>	description of formations encountered	from	to
<u>RT 4 WAGNESBORO MS</u> (mailing address)			
WELL LOCATION: sec. <u>12</u> T- <u>7N</u> R- <u>E</u> <u>2 1/4</u> miles <u>NORTH</u> of <u>BUC</u> (distance) (direction) (nearest town)	<u>TOP Soil</u>	<u>0</u>	<u>1</u>
	<u>yellow CLAY</u>	<u>1</u>	<u>6</u>
	<u>Pink yellow & white CLAY</u>	<u>6</u>	<u>12</u>
	<u>Coarse yellow SD</u>	<u>12</u>	<u>15</u>
	<u>yellow & white CLAY</u>	<u>15</u>	<u>47</u>
	<u>Bluish CLAY</u>	<u>47</u>	<u>67</u>
	<u>med white SD</u>	<u>67</u>	<u>75</u>
	<u>Coarse white SD</u>	<u>75</u>	<u>102</u>

WELL PURPOSE: Home
(home, irrigation, municipal, industrial)

WELL COMPLETION DATA:

- (1) diameter (inches) 2"
- (2) total depth (feet) 102
- (3) static water level (feet) 60 below top of ground. above
- (4) casing PVC 97
(material) (depth)
(size) If telescope see back.
- (5) screen 5' 97'
(length) (depth to top)
2" PVC 8 Slot Johnson
(size) (material)
- (6) pump 1 6 1/2
(HP) (yield gpm)
Elect
(type power)
- (7) electric log No
(yes or no)
(organization running log)
- (8) how well bottom plugged 2" PVC
CAP


DRILLERS REMARKS: still in SAND when quit

RECEIVED
DEC 10 1976

MISS. BD. OF WATER COMM

If well telescopes please sketch and show depths.

GROUND LEVEL

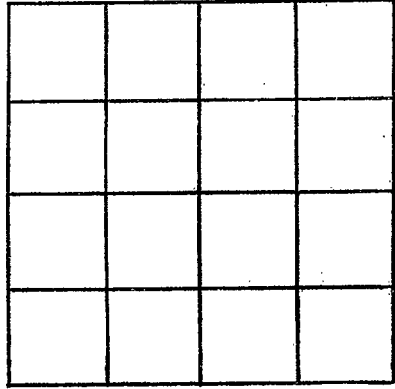

SECTION _____

Please indicate well location X.

ADDITIONAL INFORMATION

If more than one screen, show locations of each on sketch.