

Wayne
T 2016

Need date

MISSISSIPPI
BOARD OF WATER COMMISSIONERS
416 North State Street
Jackson, Mississippi 39201

WATER WELL DRILLERS LOG

J. R. GREEN - WATER WELL DRILLING Wayne

date well completed 19 7-2016 firm name J. R. GREEN - WATER WELL DRILLING PHONE 425-3237 county well located LAUREL, MISS. 39440

LANDOWNER: L. W. Conners

description of formations encountered	from	to
<u>yellow</u>	<u>0</u>	<u>5</u>
<u>SAND</u>	<u>5</u>	<u>10</u>
<u> </u>	<u>10</u>	<u>20</u>
<u> </u>	<u>20</u>	<u>28</u>
<u>White CHALK</u>	<u>28</u>	<u>30</u>
<u> </u>	<u>30</u>	<u>40</u>
<u> </u>	<u>40</u>	<u>50</u>
<u> </u>	<u>50</u>	<u>60</u>

Buckatunna, Mo

(mailing address)

WELL LOCATION:

sec. 23 T 7 N R 6 E
S W
3 miles W of Buckatunna
(distance) (direction) (nearest town)

WELL PURPOSE:
(home, irrigation, municipal, industrial)

WELL COMPLETION DATA:

- (1) diameter (inches) 4
- (2) total depth (feet) 60
- (3) static water level (feet) 8' below above top of ground.
- (4) casing PVC 23
(material) (depth)
 if telescope see back.
(size)
- (5) screen 5' 23
(length) (depth to top)
2" X .009 PVC
(size) (material)
- (6) pump 1/2 10
(HP) (yield gpm)
 (type power)
- (7) electric log No
(yes or no)
 (organization running log)
- (8) how well bottom plugged


DRILLERS REMARKS:

RECEIVED
FEB 14 1977

MISS. BD. OF WATER COMMISSIONERS

If well telescopes please sketch and show depths.

GROUND LEVEL

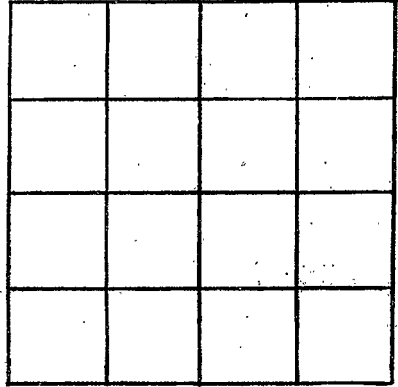

SECTION _____

Please indicate well location X.

ADDITIONAL INFORMATION

If more than one screen, show locations of each on sketch.