

WAYNE
T 308
2-24-77

MISSISSIPPI
 BOARD OF WATER COMMISSIONERS
 416 North State Street
 Jackson, Mississippi 39201

WATER WELL DRILLERS LOG

Feb. 24 1977 Porter Drilling Wayne
 date well completed firm name county well located

LANDOWNER:	description of formations encountered	from	to
<u>J. L. Powe</u>			
<u>At 1 Buckatanna</u> (mailing address)	<u>Clay</u>	<u>0</u>	<u>25</u>
	<u>Clay & sand</u>	<u>25</u>	<u>30</u>
	<u>sand</u>	<u>30</u>	<u>69</u>
	<u>silt with sand</u>		
	<u>Clay below</u>	<u>69</u>	<u>70</u>
WELL LOCATION: sec <u>27</u> T <u>7</u> N R <u>6</u> E <u>3</u> miles <u>W</u> of <u>Buckatanna</u> (distance) (direction) (nearest town)			
WELL PURPOSE: (home, irrigation, municipal, industrial)			
WELL COMPLETION DATA:			
(1) diameter (inches) <u>2"</u>	<u>5' 2" silt P.V.C</u>		
(2) total depth (feet) <u>69'</u>	<u>screen with 1/2" back</u>		
(3) static water level (feet) <u>45'</u> below top of ground.	<u>wash water on end of</u>		
(4) casing <u>P.V.C.</u> <u>64'</u> (material) (depth)	<u>shell trap above</u>		
<u>2"</u> If telescope see back. (size)	<u>62' 1" P.V.C. drop</u>		
(5) screen <u>5'</u> <u>64'</u> (length) (depth to top)	<u>pipe</u>		
<u>2"</u> <u>silt P.V.C.</u> (size) (material)			
(6) pump <u>1</u> <u>12</u> (HP) (yield gpm)			
<u>elec</u> (type power)			
(7) electric log <u>no</u> (yes or no)			
(organization running log)			
(8) how well bottom plugged <u>back wash valve</u>			
DRILLERS REMARKS:			


RECEIVED

APR 6 1977

MISSISSIPPI BOARD OF WATER COMMISSIONERS

If well telescopes please sketch and show depths.

GROUND LEVEL

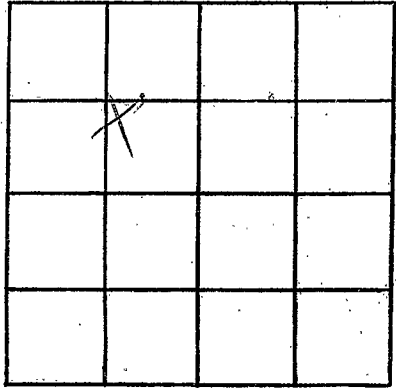

SECTION 27

Please indicate well location X.

ADDITIONAL INFORMATION

If more than one screen,
show locations of each on sketch.