

WAYNE
T 209
7-16-77

MISSISSIPPI
BOARD OF WATER COMMISSIONERS
416 North State Street
13P Jackson, Mississippi 39201

WATER WELL DRILLERS LOG

McILWAIN WATER WELL SERVICE

July 16
date well completed 1977

Wayne
county well located

LANDOWNER:

Franklin Stewart
Waynesboro, Miss.
(mailing address)

description of formations encountered

from to

Red Clay	0	8
Red Sand	8	14
Sand Rocks	14	18
Sand	18	45
Clay	45	58
Sand	58	63
Sand + Clay	63	74
Sand	74	80

WELL LOCATION:

sec. 5 T. 7 N. R. 17 E. 6 W
8 miles SE of Wboro
(distance) (direction) (nearest town)

WELL PURPOSE:

Home
(home, irrigation, municipal, industrial)

WELL COMPLETION DATA:

- (1) diameter (inches) 2"
- (2) total depth (feet) 80'
- (3) static water level (feet) 57' below above top of ground.
- (4) casing PVC 75'
(material) (depth)
2" if telescope see back.
(size)
- (5) screen 5' 75'
(length) (depth to top)
2" PVC .008
(size) (material)
- (6) pump 1 9
(HP) (yield gpm)
220 AC
(type power)
- (7) electric log No
(yes or no)

(organization running log)

(8) how well bottom plugged

DRILLERS REMARKS:


RECEIVED

SEP 19 1977

MISS. BD. OF WATER COMMISSIONERS

If well telescopes please sketch and show depths.

GROUND LEVEL

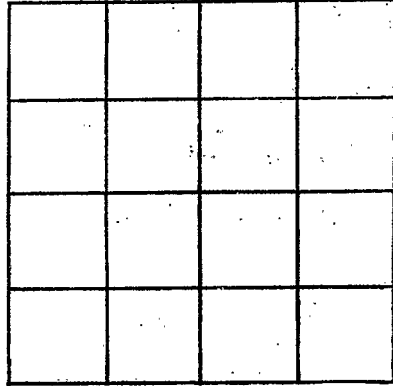

SECTION _____

Please indicate well location X.

ADDITIONAL INFORMATION

If more than one screen, show locations of each on sketch.