

WAYNE

T 2021

10-19-77

MISSISSIPPI
 BOARD OF WATER COMMISSIONERS
 416 North State Street
 Jackson, Mississippi 39201

13P

WATER WELL DRILLERS LOG

McLEWAIN WATER WELL SERVICE

Wayne

date well completed

WAYNESBORO MISS 39367

county well located

LANDOWNER:

Yonny Stevens

description of formations encountered

from

to

Waynesboro Miss
(mailing address)

SAND

0

5

CLAY

5

14

WELL LOCATION:

sec. 19 T. 27 N R. 6 E
 S W
 5 miles E of CLARA
 (distance) (direction) (nearest town)

SAND

14

22

Blue CLAY

22

28

Yellow CLAY

28

40

WELL PURPOSE: Home
(home, irrigation, municipal, industrial)

SAND & CLAY

40

70

WELL COMPLETION DATA:

SAND

70

80

- (1) diameter (inches) 2"
- (2) total depth (feet) 80'
- (3) static water level (feet) 40 below above top of ground.
- (4) casing PVC 75'
(material) (depth)
2"
(size) if telescope see back.
- (5) screen 5' 75'
(length) (depth to top)
2" PVC
(size) (material)
- (6) pump 1 10
(HP) (yield gpm)
110 AC
(type power)
- (7) electric log No
(yes or no)

(organization running log)

(8) how well bottom plugged

RECEIVED


NOV 11 1977

DRILLERS REMARKS:

MISS. BD. OF WATER COMM

If well telescopes please sketch and show depths.

GROUND LEVEL

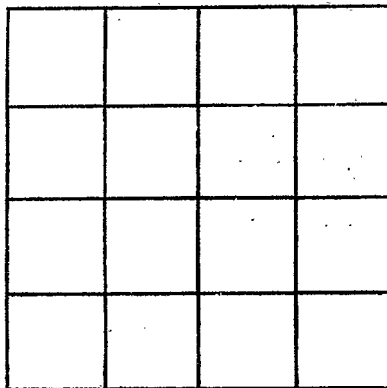

SECTION _____

Please indicate well location X.

ADDITIONAL INFORMATION

If more than one screen, show locations of each on sketch.