

WAYNE

T 0000

12/9/77

MISSISSIPPI BOARD OF WATER COMMISSIONERS 416 North State Street Jackson, Mississippi 39201

WATER WELL DRILLERS LOG

Dec 9 1977 Porter Drilling Shop Wayne date well completed firm name county well located

LANDOWNER: I. Underheat P.O. Box Hainesboro Miss. (mailing address)

WELL LOCATION: sec. 19 T. 70 N. R. 6 E. 11 miles SE of Clava (distance) (direction) (nearest town)

WELL PURPOSE: shop (home, irrigation, municipal, industrial)

WELL COMPLETION DATA: (1) diameter (inches) 2" (2) total depth (feet) 88 (3) static water level (feet) 50 below top of ground (4) casing PVC 83' (material) (depth) 2" (size) If telescope see back. (5) screen 5' 83' (length) (depth to top) 1/2" 30 mesh S.S. (size) (material) (6) pump 1 (HP) 7 (yield gpm) elec (type power) (7) electric log yes (yes or no) (organization running log) (8) how well bottom plugged 1/2" backwash valve

Table with 3 columns: description of formations encountered, from, to. Rows include: red sand (0-13), clay (13-25), silty sand & clay (25-40), clay (40-45), lime shell & clay (45-60), lined fine sand (60-75), med coarse sand (75-88), some clay (88-90), stippled clay & sand (90-95).

5' 1 1/4" burst S. S. screen with 1/2" backwash valve on end & shell trap above 73' 1" P.V.C. drop pipe


RECEIVED JAN 27 1978

MISS. BD. OF WATER COMMISSIONERS

DRILLERS REMARKS:

If well telescopes please sketch and show depths.

GROUND LEVEL

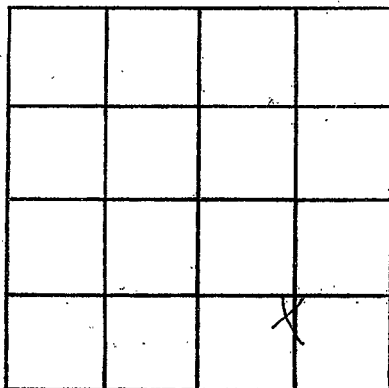

SECTION 19

Please indicate well location X.

ADDITIONAL INFORMATION

If more than one screen, show locations of each on sketch.