

WAYNE

Q T 2003

2-2-78

MISSISSIPPI BOARD OF WATER COMMISSIONERS
416 North State Street
Jackson, Mississippi 39201

WATER WELL DRILLERS LOG
MILWAUIN WATER WELL SERVICE

Feb 2 1978
date well completed

RT. 2, BOX 37
WAYNESBORO, MISS. 39367

Wayne
county well located

LANDOWNER:	description of formations encountered	from	to
Robert Moore			
Waynesboro (mailing address)	Red Clay	0	8
WELL LOCATION:	Clay	8	12
sec. 12 T. 8 N R. 6 E S W	Sand	12	15
6 miles SE of W'boro (distance) (direction) (nearest town)	Clay	15	28
WELL PURPOSE: Home (home, irrigation, municipal, industrial)	Sand	28	30
WELL COMPLETION DATA:	Clay	30	35
(1) diameter (inches) 2"	Sand + Clay	35	48
(2) total depth (feet) 105'	Clay	48	93
(3) static water level (feet) 72' below top of ground.	Sand	93	105
(4) casing PVC, 100' (material) (depth)			
2" if telescope see back. (size)			
(5) screen 5' 100' (length) (depth to top)			
2" PVC. 008 (size) (material)			
(6) pump 1 8 (HP) (yield gpm)			
220 AC (type power)			
(7) electric log No (yes or no)			
(organization running log)			
(8) how well bottom plugged			
DRILLERS REMARKS:			


RECEIVED

APR 24 1978

MISS. Bd. of WATER COMMISSIONERS

If well telescopes please
sketch and show depths.

GROUND LEVEL

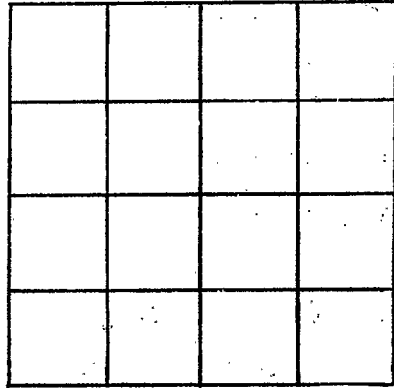

SECTION _____

Please indicate well location X.

ADDITIONAL INFORMATION

If more than one screen,
show locations of each on sketch.