

WAYNE

T

3-23-78

MISSISSIPPI BOARD OF WATER COMMISSIONERS
416 North State Street
Jackson, Mississippi 39201

MICHAEL WAIN WATER WELL DRILLERS LOG
WATER WELL SERVICE

March 23 1978
date well completed

RT. 2, BOX 37
WAYNESBORO, MISSISSIPPI 39367

Wayne
county well located


LANDOWNER:	description of formations encountered	from	to
Mangie Beard	Sand	0	15
Waynesboro Miss. (mailing address)	Clay	15	28
WELL LOCATION: sec. 30 T 07 N R 6 W S	Blue Clay	28	85
5 miles SE of CLARA (distance) (direction) (nearest town)	Fine Sand + Clay	85	93
WELL PURPOSE: Home (home, irrigation, municipal, industrial)	Med. Sand	93	99
WELL COMPLETION DATA:			
(1) diameter (inches) 2"			
(2) total depth (feet) 99'			
(3) static water level (feet) 52' below above top of ground.			
(4) casing PVC 94' (material) (depth)			
2" if telescope see back. (size)			
(5) screen 5' 94' (length) (depth to top)			
2" PVC .008 (size) (material)			
(6) pump 3/4 5 (HP) (yield gpm)			
710 AC (type power)			
(7) electric log No (yes or no)			
(organization running log)			
(8) how well bottom plugged			
DRILLERS REMARKS:			

RECEIVED
APR 24 1978

MISS. BD. OF WATER COMM.

If well telescopes please
sketch and show depths.

GROUND LEVEL

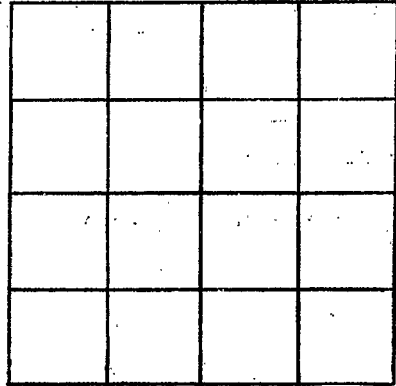

SECTION _____

Please indicate well location X.

ADDITIONAL INFORMATION

If more than one screen,
show locations of each on sketch.