

WAYNE
 T. J. JONES
 7-21-78

MISSISSIPPI
 BOARD OF WATER COMMISSIONERS
 416 North State Street
 Jackson, Mississippi 39201

WATER WELL DRILLERS LOG

July 21, 1978 MAIN WATER WELL SERVICE WAYNE
 date well completed RT. 2, fine box 37 county well located
 WAYNESBORO, MISS. 39367

LANDOWNER: Alice Henderson
 Waynesboro, MS.
 (mailing address)

WELL LOCATION:
 sec. 32 T. 7 N. R. 6 E.
 4 miles SW of BUNNA
 (distance) (direction) (nearest town)

WELL PURPOSE: HOME
 (home, irrigation, municipal, industrial)

WELL COMPLETION DATA:
 (1) diameter (inches) 2"
 (2) total depth (feet) 179'
 (3) static water level (feet) 98' below top of ground.
 (4) casing PVC 174' (material) (depth)
 2" (size) if telescope see back.
 (5) screen 5' 174' (length) (depth to top)
 2" PVC .003 (size) (material)
 (6) pump 1 1/2 4 (HP) (yield gpm)
 220 AC (type power)
 (7) electric log NO (yes or no)
 (organization running log)
 (8) how well bottom plugged

description of formations encountered	from	to
SAND	0	5
Red Sandy Clay	5	11
Clay	11	14
SAND + Clay	14	18
Clay	18	95
SAND + Clay	95	100
Clay	100	115
FINE SAND +		
Clay	115	140
Clay	140	165
SAND	165	179


RECEIVED
 AUG 11 1978

DRILLERS REMARKS:

MISS. BD. OF WATER COMM

If well telescopes please sketch and show depths.

GROUND LEVEL

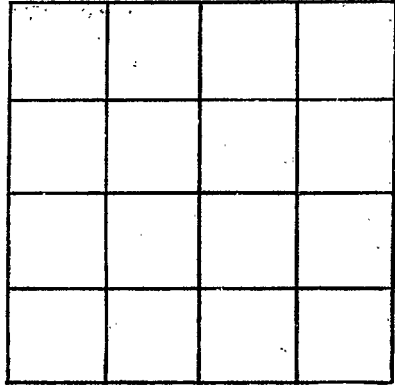

SECTION _____

Please indicate well location X.

ADDITIONAL INFORMATION

If more than one screen,
show locations of each on sketch.