

WAYNE

~~T~~

6-30-78

MISSISSIPPI  
BOARD OF WATER COMMISSIONERS  
416 North State Street  
Jackson, Mississippi 39201

WATER WELL DRILLERS LOG

June 30

date well completed

McILWAIN WATER WELL SERVICE

1978

RT. 2, firm name

WAYNESBORO, MISS. 39367

WAYNE

county well located

LANDOWNER Mrs. Myrtle Taylor

description of formations encountered

from

to

Rt. 1 Box 96

Red Sandy Clay

0 5

Waynesboro, Ms.

(mailing address)

Clay

5 30

WELL LOCATION:

sec 32 T 1 N R 6

Blue Clay

30 70

4 miles SW of B/TUNN

(distance) (direction) (nearest town)

WELL PURPOSE:

(home, irrigation, municipal, industrial)

Clay + Fine

WELL COMPLETION DATA:

(1) diameter (inches) 2"

SAND STREAKS

70 100

(2) total depth (feet) 159'

(3) static water level (feet) 89' below top of ground

Clay

100 145

(4) casing PVC 154' (material) (depth)

(Med.) Sand

145 159

2" (size) if telescope see back.

(5) screen 5' 154' (length) (depth to top)

2" PVC .008 (size) (material)

(6) pump 1/4 (HP) 4 (yield gpm)

220 AC (type power)

(7) electric log NO (yes or no)

(organization running log)

(8) how well bottom plugged


DRILLERS REMARKS:

RECEIVED  
JUN 11 1978

MISS. BD. OF WATER COMMISSIONERS

If well telescopes please sketch and show depths.

GROUND LEVEL

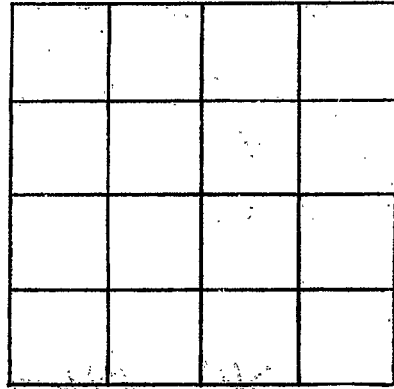

SECTION \_\_\_\_\_

Please indicate well location X.

ADDITIONAL INFORMATION

If more than one screen,  
show locations of each on sketch.