

WAYNE
 T5057
 8-4-78

MISSISSIPPI
 BOARD OF WATER COMMISSIONERS
 416 North State Street
 Jackson, Mississippi 39201

WATER WELL DRILLERS LOG
 McILWAIN WATER WELL SERVICE

Aug. 4 1978 RT. 2, BOX 37 WAYNESBORO, MISS. 39367 Wayne
 date well completed name of well county well located

LANDOWNER: Robert Gossett

Waynesboro, MS.
 (mailing address)

WELL LOCATION:
 sec. 27 T. 2 N R. 6 E
 5 miles W of Turnna
 (distance) (direction) (nearest town)

WELL PURPOSE:
 (home, irrigation, municipal, industrial)

WELL COMPLETION DATA:


- (1) diameter (inches) 2"
- (2) total depth (feet) 160'
- (3) static water level (feet) 98' below top of ground
- (4) casing PVC, 155' (material) (depth)
 2" (size) if telescope see back.
- (5) screen 5' 155' (length) (depth to top)
 2" PVC (material) (size) (depth to top)
- (6) pump 1 1/2 5 (HP) (yield gpm)
 220 AC (type power)
- (7) electric log NO (yes or no)

(organization running log)

(8) how well bottom plugged

DRILLERS REMARKS:

description of formations encountered	from	to
Red SAND	0	8
Clay	8	25
Blue Clay	25	90
Mixed Clay +		
Fine SAND	90	125
Med. SAND	125	130
SAND + Clay	130	140
SAND	140	147
Clay	147	150
SAND	150	160

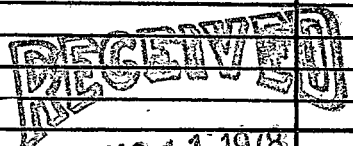


AUG 11 1978

MISS. BD. OF WATER COMMISSIONERS

If well telescopes please sketch and show depths.

GROUND LEVEL

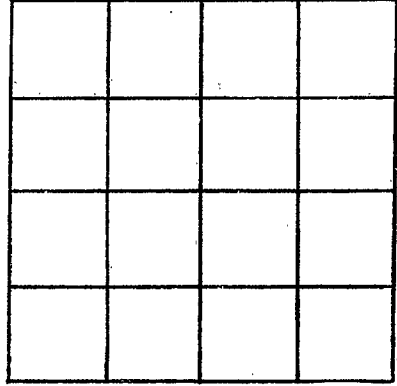

SECTION _____

Please indicate well location X.

ADDITIONAL INFORMATION

If more than one screen,
show locations of each on sketch.