

WAYNE

T 2028

8-17-78

MISSISSIPPI BOARD OF WATER COMMISSIONERS 416 North State Street Jackson, Mississippi 39201

WATER WELL DRILLERS LOG

McILWAIN WATER WELL SERVICE

WAYNE

Aug 17

1978

RT. 2 BOX 37

firm name

WAYNESBORO, MISS. 39367

county well located

LANDOWNER:

DIANE Smith

Waynesboro Ms

(mailing address)

description of formations encountered

from

to

Red Clay

0

8

Clay

8

17

WELL LOCATION:

sec. 32 T. 7 N R. 6 E 07 miles SW of Blumina (distance) (direction) (nearest town)

SAND + CLAY

17

55

Clay

55

82

WELL PURPOSE: Home (home, irrigation, municipal, industrial)

SAND

82

85

WELL COMPLETION DATA:

Clay

85

170

(1) diameter (inches) 2"

FINE SAND + CLAY

170

190

(2) total depth (feet) 207'

MED SAND

190

207

(3) static water level (feet) 77' below top of ground.

(4) casing PVC 197' (material) (depth)

2" (size) if telescope see back.

(5) screen 10' 197' (length) (depth to top)

2" PVC 008 (size) (material)

(6) pump 1 (HP) 7 (yield gpm)

220 Ac (type power)

(7) electric log No (yes or no)

(organization running log)

(8) how well bottom plugged


DRILLERS REMARKS:

RECEIVED OCT 26 1978

MISS. BD. OF WATER COMMISSIONERS

If well telescopes please sketch and show depths.

GROUND LEVEL

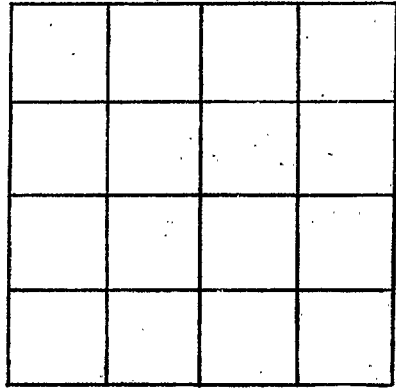

SECTION _____

Please indicate well location X.

ADDITIONAL INFORMATION

If more than one screen,
show locations of each on sketch.