

Wayne  
T 2031  
May 22, 1979

MISSISSIPPI  
BOARD OF WATER COMMISSIONERS  
416 North State Street  
Jackson, Mississippi 39201

WATER WELL DRILLERS LOG

May 22 1979 Porter Drilling & Log Wayne  
date well completed firm name county well located

LANDOWNER: Y. B. Taylor

description of formations encountered

feet

Box 1 Buckatanna, Miss  
(mailing address)

sand  
stippled clay

0

WELL LOCATION:

sec 23 T 7 (N) R 6 (E)  
2 miles NW of Buckatanna  
(distance) (direction) (nearest town)

21' 1' P.V.C. drag pipe

WELL PURPOSE: Home  
(home, irrigation, municipal, industrial)

WELL COMPLETION DATA:

- (1) diameter (inches) 2"
- (2) total depth (feet) 28'
- (3) static water level (feet) 12 <sup>below</sup> <sub>above</sub> top of ground.
- (4) casing P.V.C. 23'  
(material) (depth)  
2"  
(size) if telescope see back.
- (5) screen 5' 23  
(length) (depth to top)  
2" 2 sch P.V.C.  
(size) (material)
- (6) pump 1 12  
(HP) (yield: gpm)  
elec  
(type power)
- (7) electric log no  
(yes or no)

(organization running log)

(8) how well bottom plugged

by back wash valve

DRILLERS REMARKS:


Miss. Board of Water Comm.

JUN 18 1979

RECEIVED

If well telescopes please sketch and show depths.

GROUND LEVEL

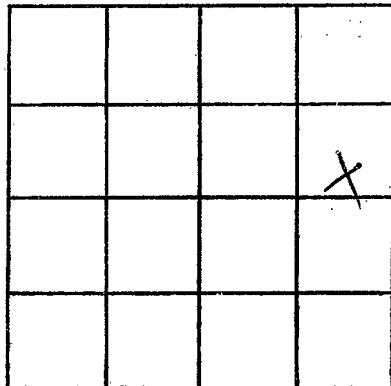

SECTION 23

Please indicate well location X.

ADDITIONAL INFORMATION

If more than one screen,  
show locations of each on sketch.