

MISSISSIPPI DEPARTMENT OF NATURAL RESOURCES

Bureau of Land and Water Resources

Southport Mall

P.O. Box 10631

Jackson, Mississippi 39209

WATER WELL DRILLERS LOG

Wayne
T 2032
8-18-81

Aug 18 1981 date well completed
Booster Drilling Log firm name
Wayne county well located

LANDOWNER: W.C. Rowe
Rt 4 Waynesboro,
Miss.
(mailing address)

WELL LOCATION:
sec. 12 T. 7 N. R. 6 E. S. 3
3 miles N of Buckatunna
(distance) (direction) (nearest town)

WELL PURPOSE: home
(home, irrigation, municipal, industrial)

WELL COMPLETION DATA:

- (1) diameter (inches) 2"
- (2) total depth (feet) 55'
- (3) static water level (feet) 31' below top of ground.
- (4) casing P.V.C. 50'
(material) (depth)
2" If telescope see back.
(size)
- (5) screen 5' 50'
(length) (depth to top)
2" slot P.V.C.
(size) (material)
- (6) pump 1 7
(HP) (yield gpm)
elec.
(type power)
- (7) electric log no
(yes or no)

(8) how well bottom plugged
2 sand slab

DRILLERS REMARKS:

description of formations encountered	from	to
Clay	0	8
fine sand	8	19
Clay	19	40
sand	40	43
Clay	43	46
sand	46	55
tip of white shell in sand		
42' 1" P.V.C. drag pipe		


DEPT. OF NATURAL RESOURCES
BUREAU OF LAND & WATER RESOURCES

SEP - 9 1981

RECEIVED

If well telescopes please sketch and show depths.

GROUND LEVEL

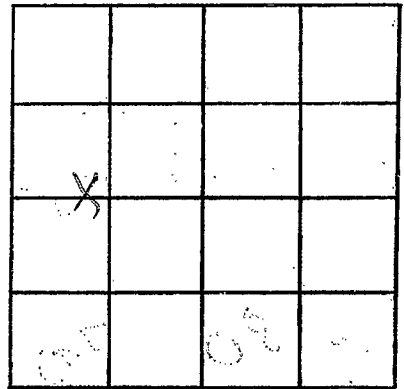

SECTION 12

Please indicate well location X.

ADDITIONAL INFORMATION

If more than one screen,
show locations of each on sketch.