

Wayne
T2033

MISSISSIPPI
BOARD OF WATER COMMISSIONERS
416 North State Street
Jackson, Mississippi 39201

WATER WELL DRILLERS LOG

7-7 1982 CARRS well SERV WAYNE
date well completed firm name county well located

LANDOWNER: W. T. CARR
BUCKATONNA MS

| description of formations encountered | from | to |
|---------------------------------------|------|----|
| | | |

(mailing address)

| | | |
|------------------------|-----------|-----------|
| <u>Bluish CLAY</u> | <u>0</u> | <u>12</u> |
| <u>Med white SD</u> | <u>12</u> | <u>16</u> |
| <u>CoARSE white SD</u> | <u>16</u> | <u>26</u> |

WELL LOCATION:
sec. T 20 N R. 6 E
S W
1 miles WSW of BUC
(distance) (direction) (nearest town)

| | | |
|--------------------------|-----------|-----------|
| <u>Blue CLAY</u> | <u>26</u> | <u>42</u> |
| <u>Pink+white CLAY</u> | <u>42</u> | <u>55</u> |
| <u>Blue CLAY</u> | <u>55</u> | <u>75</u> |
| <u>BROKEN BROWN ROCK</u> | | |
| <u>PINK CLAY</u> | <u>75</u> | <u>78</u> |
| <u>Pink+ Blue CLAY</u> | <u>78</u> | <u>95</u> |

WELL PURPOSE: Pond
(home, irrigation, municipal, industrial)

| | | |
|--------------------------|------------|------------|
| <u>Blue CREAMY CLAY</u> | <u>95</u> | <u>100</u> |
| <u>CREAMY CLAY</u> | <u>100</u> | <u>135</u> |
| <u>BROKEN white CLAY</u> | | |
| <u>Med white SAND</u> | <u>135</u> | <u>145</u> |
| <u>CoARSE white SAND</u> | <u>145</u> | <u>160</u> |

WELL COMPLETION DATA:

| | | |
|--|--|--|
| (1) diameter (inches) <u>2"</u> | | |
| (2) total depth (feet) <u>160</u> | | |
| (3) static water level (feet) <u>1</u> <u>below</u> <u>above</u> | | |
| (4) casing <u>PVC</u> , <u>155'</u> | | |
| (material) (depth) | | |

(1) diameter (inches) 2"

(2) total depth (feet) 160

(3) static water level (feet) 1 below above

(4) casing PVC, 155'

(size) if telescope see back.

(5) screen 5', 155'

(length) (depth to top)

2" PVC (10564)

(size) (material)

(6) pump None 21

(HP) (yield gpm)

None

(type power)

(7) electric log NO

(yes or no)

(organization running log)

(8) how well bottom plugged 2" PVC cap

DRILLERS REMARKS: still in sand when quit


DEPT OF NATURAL RESOURCES
BUREAU OF LAND & WATER RESOURCES

NOV 1 1982

RECEIVED

If well telescopes please sketch and show depths.

GROUND LEVEL

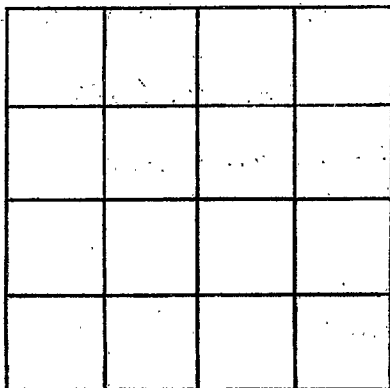

SECTION _____

Please indicate well location X.

ADDITIONAL INFORMATION

If more than one screen,
show locations of each on sketch.