

MISSISSIPPI DEPARTMENT OF NATURAL RESOURCES

Bureau of Land and Water Resources

Southport Mall

P.O. Box 10631

Jackson, Mississippi 39209

WATER WELL DRILLERS LOG

Wayne  
T  
2034

Oct 8 1982 date well completed  
Porter Drilling, Inc firm name  
Wayne county well located

LANDOWNER: Elbridge  
Williams Rt 3B W 212  
Waynesboro, Miss  
(mailing address)

WELL LOCATION:  
sec 2 T 7 N R 6 E  
4 miles S of Waynesboro  
(distance) (direction) (nearest town)

WELL PURPOSE: Home  
(home, irrigation, municipal, industrial)

WELL COMPLETION DATA:  
(1) diameter (inches) 2"  
(2) total depth (feet) 156  
(3) static water level (feet) 88 (below above top of ground.)  
(4) casing PVC 151'  
(material) (depth)  
2" (size) if telescope see back.  
(5) screen 5' 151'  
(length) (depth to top)  
2" (size) brass SS (material)  
(6) pump 2 12  
(HP) (yield gpm)  
eles (type power)  
(7) electric log no (yes or no)  
(organization running log)  
(8) how well bottom plugged  
2" sand stone

description of formations encountered	from	to
clean sand	0	25
clay	25	90
thin sand		90
fine sand & clay	90	97
clay	97	134
med sand	134	156
stone white shell		
in sand		
102' 1" P.V.C. down pipe		

DEPT. OF NATURAL RESOURCES  
BUREAU OF LAND & WATER RESOURCES


OCT 25 1982

RECEIVED

DRILLERS REMARKS:

If well telescopes please sketch and show depths.

GROUND LEVEL

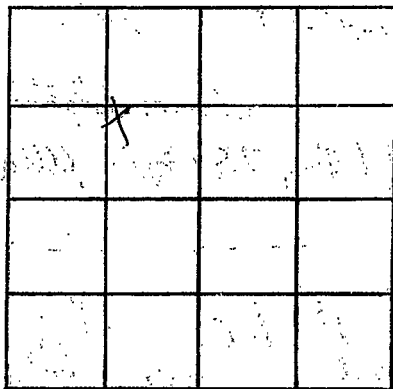

SECTION 2

Please indicate well location X.

ADDITIONAL INFORMATION

If more than one screen, show locations of each on sketch.