

Wayne
T
2035

MISSISSIPPI
BOARD OF WATER COMMISSIONERS
416 North State Street
Jackson, Mississippi 39201

WATER WELL DRILLERS LOG

5-5-83 1983 CARMS well service WAYNE
date well completed firm name county well located

LANDOWNER: <u>JAMES MCCOY</u>	description of formations encountered	from	to
<u>RBI BUCKATONNA MS</u>	<u>Fine white SD</u>	<u>0</u>	<u>15</u>
	<u>med yellow SAND</u>	<u>15</u>	<u>17</u>
	<u>yellow CLAY</u>	<u>17</u>	<u>19</u>
(mailing address)	<u>Fine Yellow SD</u>	<u>19</u>	<u>25</u>
WELL LOCATION:	<u>Fine Bluish SAND w/</u>		
sec <u>25</u> T <u>7</u> N R <u>6</u> E	<u>Blue MARL</u>	<u>25</u>	<u>29</u>
S (W)	<u>med white SD</u>	<u>29</u>	<u>31</u>
<u>1 1/2</u> miles <u>West</u> of <u>Buc</u>	(Log)	<u>31</u>	<u>32</u>
(distance) (direction) (nearest town)	<u>med white SD</u>	<u>32</u>	<u>34</u>
WELL PURPOSE: <u>CAMP</u>	<u>Fine Tight yellow SD</u>	<u>34</u>	<u>36</u>
(home, irrigation, municipal, industrial)	<u>Blue white CLAY</u>	<u>36</u>	<u>38</u>
WELL COMPLETION DATA:	<u>White CLAY</u>	<u>38</u>	<u>75</u>
(1) diameter (inches) <u>2"</u>	<u>Fine white SD</u>	<u>75</u>	<u>90</u>
(2) total depth (feet) _____	<u>med white SD</u>	<u>90</u>	<u>95</u>
(3) static water level (feet) <u>1'</u> <u>below</u> <u>above</u> top of ground.			
(4) casing <u>PVC</u> , <u>90</u> (material) (depth) (size) If telescope see back.			
(5) screen <u>5'</u> , <u>90</u> (length) (depth to top)			
<u>2"</u> , <u>PVC</u> (size) (material)			
(6) pump <u>3/4</u> , <u>14</u> (HP) (yield gpm)			
<u>Elect</u> (type power)			
(7) electric log <u>No</u> (yes or no)			
(organization running log)			
(8) how well bottom plugged <u>2" PVC</u> <u>CAP</u>			
DRILLERS REMARKS: <u>still in</u> <u>sand</u>			


DEPT. OF NATURAL RESOURCES
BUREAU OF LAND & WATER RESOURCES

JUN 16 1983

RECEIVED

If well telescopes please sketch and show depths.

GROUND LEVEL

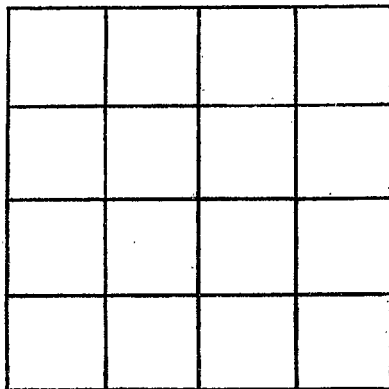

SECTION _____

Please indicate well location X.

ADDITIONAL INFORMATION

If more than one screen, show locations of each on sketch.