

MISSISSIPPI DEPARTMENT OF NATURAL RESOURCES

Bureau of Land and Water Resources

Southport Mall

P.O. Box 10631

Jackson, Mississippi 39209

WATER WELL DRILLERS LOG

Wayne
T. 2036

8/29

1984 CARR'S WELL SER

WAYNE

date well completed

firm name

county well located

LANDOWNER: ISSAC CARR

DT. 1

description of formations encountered

from

to

TOP SOIL 0 2

VEL. SD. 2 10

C. WH. SD. 10 26

BLU CLAY 26 50

BRN & BLU. S. 50 58

G. WH. SD. 58 60

BLU. CLAY 60 78

BRN. BLU. CL. & W. SD. 78 96

MED. WH. SD. 96 102

BLU. CLAY. 102 103

MED. T. CL. SID 103 113

BUCKATUNNA MS, 39323
(mailing address)

WELL LOCATION:

sec. 24 T 70 N R 6 E
S 3 miles W of BUCK
(distance) (direction) (nearest town)

WELL PURPOSE: CHICKEN HOUSE
(home, irrigation, municipal, industrial)

WELL COMPLETION DATA:

- (1) diameter (inches) 2"
- (2) total depth (feet) 113
- (3) static water level (feet) 30 below above top of ground.
- (4) casing PVC. 95'
(material) (depth)
2" If telescope see back.
(size)
- (5) screen 5' 90
(length) (depth to top)
2" PVC.
(size) (material)
- (6) pump 1 7
(HP) (yield gpm)
ELFC.
(type power)
- (7) electric log NO
(yes or no)

(organization running log)

(8) how well bottom plugged CAPPED

DRILLERS REMARKS:


DEPT. OF NATURAL RESOURCES
BUREAU OF LAND & WATER RESOURCES

SEP - 4 1984

RECEIVED

If well telescopes please
sketch and show depths.

GROUND LEVEL

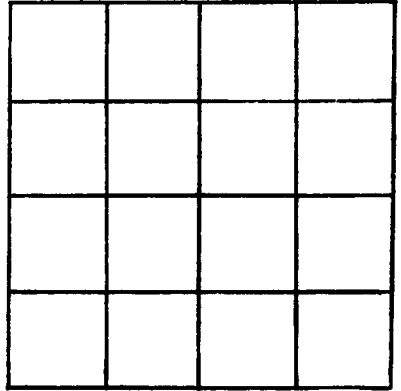

SECTION _____

Please indicate well location X.

ADDITIONAL INFORMATION

If more than one screen,
show locations of each on sketch.