

MISSISSIPPI DEPARTMENT OF ENVIRONMENTAL QUALITY
Office of Land and Water Resources

P. O. Box 10631
 Jackson, MS 39289-0631
WATER WELL DRILLERS LOG

COUNTY WELL LOCATED
Wayne

WELL NUMBER CODED
7-2043

DATE WELL COMPLETED
5-11-01

PERMIT NUMBER

NAME OF DRILLING FIRM
Thompson Bros

NAME & MAILING ADDRESS OF LANDOWNER
Spomer Petroleum
956 Deposit Guaranty Plaza
210 E. Capitol St.
Jackson MS 39201

WELL LOCATION: SEC TOWNSHIP RANGE
5 7 N 6 E

DISTANCE DIRECTION NEAREST TOWN
5 Miles SE of Waynesboro

OTHER LANDMARK

WELL PURPOSE: Home, Irrigation, Municipal, Industrial, Fish Pond, etc.
rig supply

PUMP DATA

PUMP TYPE (Circle One):
 Submersible Turbine, Jet, Flowing Well,
 Other (Describe) _____

POWER TYPE (Circle One):
 Electric, Tractor, Diesel, Gasoline, Butane,
 Other (Describe) _____ H/P _____

Pump Capacity (GPM) No. of Stages Setting Depth
 _____ FT.

PUMP TEST
 Well yielded 35 GPM with
 a drawdown of 5 ft.
 after airlift ~~hours of pumping~~

WELL DATA

Well Depth <u>180</u>	Casing Diameter (In.) <u>4</u>	Casing Length (Ft.) <u>160</u>
Type of Casing <u>PVC</u>	Hole Depth <u>190</u>	Depth to Static Water Level <u>100</u>

LOG DATA

TYPE OF LOG RUN (Circle One):
 No Log Run,
 Electric, Gamma Ray, Density, Sonic, Neutron,
 Other (Describe) _____

Name of Organization Running Log

TYPE OF COMPLETION: (Circle One or More):
 Gravel Packed Underreamed, Telescoped,
 Natural Development, Open-Hole, Other
 (Describe) _____

WELL GROUTED TO A DEPTH OF 10 FEET
 Type Grout (circle one): Cement, Bentonite, or Mix

GEOLOGIC DATA (Office Use Only)

Surface Elev.	Geologic Unit	Unit Thickness	Depth to Top
Subs. SWL	Date	Analysis	Aquifer Test

Driller's Remarks

Top of Lap Pipe or Reduction in Casing

FEET IF TELESCOPED OR MORE THAN ONE SCREEN: USE BACK PAGE

SCREEN DATA

Diameter - Inches <u>4</u>	Length - Feet <u>20</u>	Slot Size - Inches <u>.020</u>
Screen Type <u>PVC slot</u>	Depth to Bottom - Feet <u>180</u>	


DESCRIPTION OF FORMATIONS ENCOUNTERED	FROM	TO
<u>clay</u>	<u>0</u>	<u>65</u>
<u>sand</u>	<u>65</u>	<u>120</u>
<u>clay</u>	<u>120</u>	<u>130</u>
<u>sand</u>	<u>130</u>	<u>190</u>

FORMATIONS (Continued)	FROM	TO

REC'D JUN 25 2001

If well telescopes please
sketch and show depths.

GROUND LEVEL

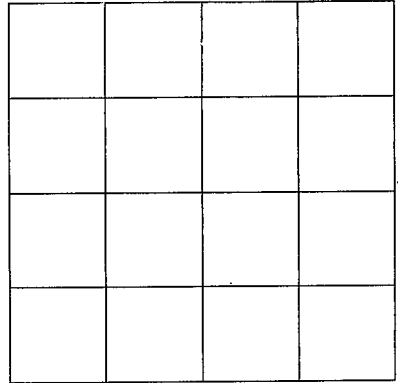

SECTION _____

Please indicate well location X.

ADDITIONAL INFORMATION

If more than one screen,
show location of each on sketch.