

WAYNE MISSISSIPPI BOARD OF WATER COMMISSIONERS

U1
10-31-63

WATER WELL DRILLERS LOG

Date: Oct 31, 1963, Driller: Dot's Drilling & Pump County Wayne
(Name)

- (1) Owner of Land: Joe Kelley
(Name)
Box 4 Nagsboro
(Address)
- (2) Location: NE 1/4, NW 1/4, Sec. 18 T2R5
3 miles north, of Buckatunga
(distance) (direction) (Nearest Town)
- (3) Topography: flat
(Hilly) (Flat) (Level)
- (4) Purpose of Well: domestic
(Domestic Irrigation
Municipal, Industrial, Other)

Description & Color of Materials Sand, Clay, Red Clay, Shell, etc.	Thick- ness Feet	Depth Feet
<u>red clay</u>	<u>8</u>	<u>8</u>
<u>yellow sand</u>	<u>13</u>	<u>21</u>
<u>sand & chalk</u>	<u>16</u>	<u>37</u>
<u>rock</u>	<u>1</u>	<u>38</u>
<u>chalk</u>	<u>16</u>	<u>54</u>
<u>sand & chalk</u>	<u>7</u>	<u>61</u>
<u>fine med sand</u>	<u>14</u>	<u>75</u>
<u>close sand</u>	<u>8</u>	<u>83</u>
<u>chalk</u>	<u>1</u>	<u>84</u>

Information upon completion of well:

- (1) Diameter 2" inches.
- (2) Total Depth 75' feet.
- (3) Water Level 59' feet below top of ground.
- (4) Cased to 69', Size 2"
- (5) Screen: Size 1 1/4", Length 6'
#60 ga. by 255
- (6) Were any formations sealed against pollution?


yes, no.

If YES depth of formation _____

Why _____

Drillers Remarks: 3/4 HP Jet

Clear H₂O

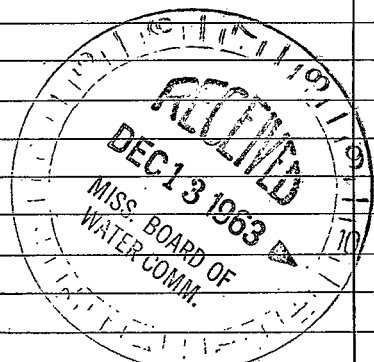

(Use Back Side)

Well No.

