

WAYNE MISSISSIPPI BOARD OF WATER COMMISSIONERS

U 5

9-21-61

WATER WELL DRILLERS LOG

Date: 9/21, 1961, Driller: C. J. Clark County Wayne
 Elev. 162 (Name)

(1) Owner of Land: Tom Durbeton
 (Name)

Bucaturra, Miss
 (Address)

(2) Location: NW 1/4, SE 1/4, Sec 30 T. R.
In the town of Bucaturra
 (distance) (direction) (Nearest Town)

(3) Topography: (Hilly) (Flat) (Level)

(4) Purpose of Well: Domestic
 (Domestic Irrigation, Municipal, Industrial, Other)

Description & Color of Materials Sand, Clay, Red Clay, Shell, etc.	Thick- ness Feet	Depth Feet
<u>0-10 Clay</u>	<u>10</u>	<u>10</u>
<u>10-40 Brown Sand</u>	<u>30</u>	<u>40</u>
<u>40-175 Clay</u>	<u>135</u>	<u>175</u>
<u>175-210 Sand</u>	<u>35</u>	<u>210</u>
<u>210-638 Blue Clay</u>	<u>428</u>	<u>638</u>
<u>638-680 Sand</u>	<u>42</u>	<u>680</u>
<u>680-690 Clay</u>	<u>10</u>	<u>690</u>

Information upon completion of well:

(1) Diameter 2 inches.

(2) Total Depth 680 feet.

(3) Water Level Well flowed +20 feet below top of ground. 5/65

(4) Cased to 634, Size 2 in.

(5) Screen: Size None, Length _____

(6) Were any formations sealed against pollution?
 yes, _____ no.


If YES depth of formation 46 and at 678.

Why Keep Surface Water out

Drillers Remarks: Well flowed

@ 20 H. P. M.

Temp. 75°
 pH 8.6
 Sp. cond. 800

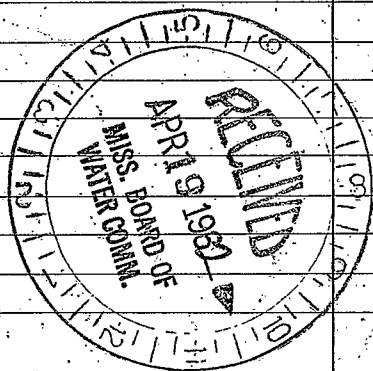

(Use Back Side)

Well No.

