

Wayne
 U 9
 11-67

MISSISSIPPI
 BOARD OF WATER COMMISSIONERS
 416 North State Street
 Jackson, Mississippi 39201

WATER WELL DRILLERS LOG

Nov 15 1967 date well completed
 Barton Drilling & Exp firm name
 Wayne county well located

LANDOWNER: Levey Singley
211 Buchatunnes
 (mailing address)

WELL LOCATION:
 sec. 4 T. 7 (N) R. 5 (E) S. (W)
11 miles SE of Waynes
 (distance) (direction) (nearest town)


WELL PURPOSE: Line
 (home, irrigation, municipal, industrial)

WELL COMPLETION DATA:

- (1) diameter (inches) 2"
- (2) total depth (feet) 100'
- (3) static water level (feet) 57 below above top of ground.
- (4) casing steel, 93,
 (material) (depth)
2"
 (size) if telescope see back.
- (5) screen 5', 95
 (length) (depth to top)
1/4, 8 shot Johnson S.S.
 (size) (material)
- (6) pump 1, 8
 (HP) (yield gpm)
elec
 (type power)
- (7) electric log no
 (yes or no)

 (organization running log)
- (8) how well bottom plugged
flashed pump


description of formations encountered	from to	
	feet	feet
red clay	0	10
Chalk	10	18
red sand	18	30
sand & chalk	30	34
Chalk	34	85
sand & chalk	85	92
Course white sand	92	100
stagnant white still in sand		

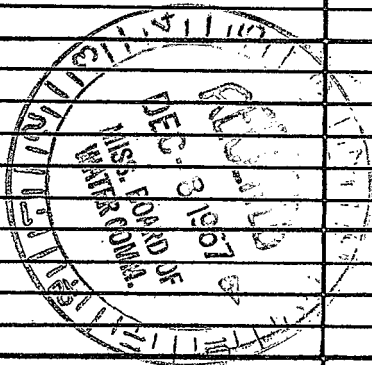

DRILLERS REMARKS:

If well telescopes please sketch and show depths.

GROUND LEVEL

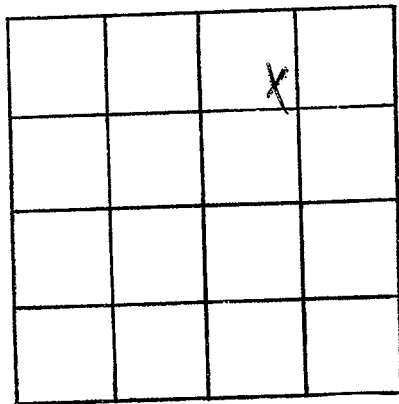

SECTION 4

Please indicate well location X.

ADDITIONAL INFORMATION

If more than one screen, show locations of each on sketch.