

WAYNE MISSISSIPPI BOARD OF WATER COMMISSIONERS

U12

5-13-65

WATER WELL DRILLERS LOG

Date: May 13, 1965, Driller: Porter Drilling & Log Co. Wayne
 (Name)


(1) Owner of Land: Harvey J. Jones
 (Name)
Rt 1 Buckatanna
 (Address)
 (2) Location: SE 1/4, SE 1/4, Sec. 16 T7R5
3 miles NE of Buckatanna
 (distance) (direction) (Nearest Town)
 (3) Topography: Hilly
 (Hilly) (Flat) (Level)
 (4) Purpose of Well: Domestic
 (Domestic Irrigation
 Municipal, Industrial, Other)

Description & Color of Materials Sand, Clay, Red Clay, Shell, etc.	Thick-ness Feet	Depth Feet
<u>red clay</u>	<u>5</u>	<u>5</u>
<u>Chalk</u>	<u>14</u>	<u>19</u>
<u>red sand</u>	<u>28</u>	<u>47</u>
<u>Chalk</u>	<u>23</u>	<u>70</u>
<u>med coarse sand</u>	<u>21</u>	<u>91</u>
<u>stoped on chalk</u>		

Information upon completion of well:

(1) Diameter 2" inches.
 (2) Total Depth 91' feet.
 (3) Water Level 70' feet below top of ground.
 (4) Cased to 86', Size 2"
 (5) Screen: Size 1/4", Length 5'
Johnson S.S. 10 slot
 (6) Were any formations sealed against pollution?
well in well cylinder
 yes, no.

If YES depth of formation _____
 Why _____
 Drillers Remarks: _____

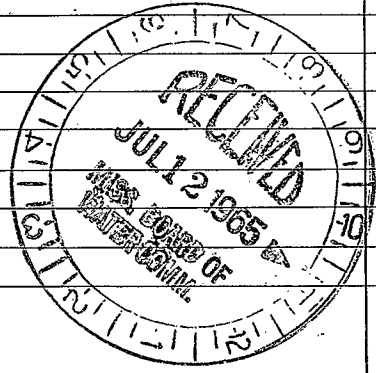

(Use Back Side)

Well No.

