

Wayne

U15

8-66

MISSISSIPPI BOARD OF WATER COMMISSIONERS

WATER WELL DRILLERS LOG

Date: Aug 19, 1966, Driller: Porter Drilling Co. County: Wayne (Name)


(1) Owner of Land: G. C. McCary (Name)
(2) Location: NW 1/4, NE 1/4, Sec. 21 T. 7 R. 5, 3 miles NE of Buckatanna (Address, direction, Nearest Town)
(3) Topography: hilly (Hilly, Flat, Level)
(4) Purpose of Well: domestic (Domestic Irrigation, Municipal, Industrial, Other)

Table with 4 columns: Description & Color of Materials, Thickness Feet, Depth Feet. Rows include: red sandy clay, sand & iron rock layers, white chalk, sand & chalk, chalk, fine sand, coarse sand, Chalk, sand & some chalk, blue chalk, sand, Chalk blue, sand, blue chalk, rock strata, shelf, rock, chalk & sand, coarse blue sand, tapered white, still in sand.

Information upon completion of well:

(1) Diameter 2 inches.
(2) Total Depth 292 feet.
(3) Water Level 15 feet below top of ground.
(4) Cased to 269, Size 2
(5) Screen: Size 1 1/4, Length 10, 8 slot Johnson S.S.
(6) Were any formations sealed against pollution? yes, X no.

If YES depth of formation
Why
Drillers Remarks:

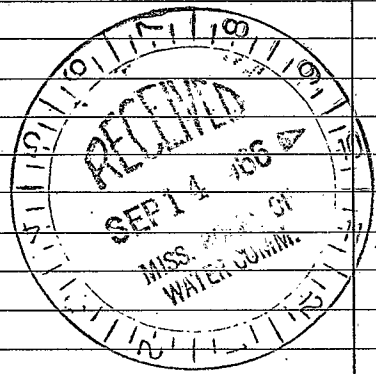

(Use Back Side)

Well No.

