

Wayne
U 17
11-67

MISSISSIPPI
BOARD OF WATER COMMISSIONERS
416 North State Street
Jackson, Mississippi 39201

WATER WELL DRILLERS LOG

Nov 2 1967 Porter Drilling & Ship Wayne
date well completed firm name county well located

LANDOWNER: Henry Lee
Crane

description of formations encountered from to

Dr I Buckatonna Miss
(mailing address)

sand 0 18
sand & chalk 18 28
Chalk 28 36
sand 36 58

WELL LOCATION:
sec 26 T 7 (N) R 5 (E)
10 miles SE of Waynesboro
(distance) (direction) (nearest town)

stopped while still in sand

WELL PURPOSE: Home
(home, irrigation, municipal, industrial)

WELL COMPLETION DATA:


- (1) diameter (inches) 2"
- (2) total depth (feet) 58
- (3) static water level (feet) 27 below above top of ground.
- (4) casing steel, 53,
(material) (depth)
2" if telescope see back.
(size)
- (5) screen 5', 53
(length) (depth to top)
1/4, Zalot Johnson S.S.
(size) (material)
- (6) pump 1/2, 6
(HP) (yield gpm)
elec
(type power)

(7) electric log no
(yes or no)

(organization running log)

(8) how well bottom plugged plugged

DRILLERS REMARKS:

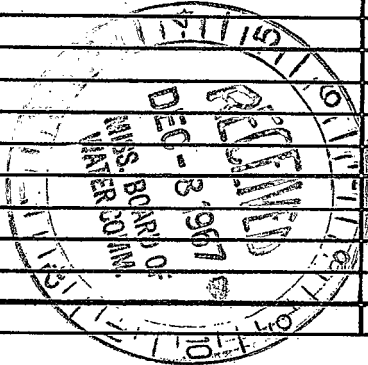

If well telescopes please sketch and show depths.

GROUND LEVEL

X			

SECTION 26

Please indicate well location X.

ADDITIONAL INFORMATION

If more than one screen,
show locations of each on sketch.