

WAYNE MISSISSIPPI BOARD OF WATER COMMISSIONERS

U19

4-17-65

WATER WELL DRILLERS LOG

Date April 17, 1965, Driller Porter Drilling & Pipe Co. Wayne

(Name)

(1) Owner of Land: Coyte Taylor

(Name)

Buchatanna Miss

(Address)

(2) Location: SW 1/4, SE 1/4, Sec. 30 T.7 R.5

1/4 miles SE of Buchatanna

(distance)

(direction)

(Nearest Town)

(3) Topography: flat

(Hilly)

(Flat)

(Level)

(4) Purpose of Well: domestic

(Domestic Irrigation Municipal, Industrial, Other)

Description & Color of Materials Sand, Clay, Red Clay, Shell, etc.

Thick-ness Feet

Depth Feet

Description & Color of Materials	Thick-ness Feet	Depth Feet
red clay	4	4
chalk	12	16
med coarse sand	23	39

Information upon completion of well:

(1) Diameter 2 inches.

(2) Total Depth 39 feet.

(3) Water Level 13 feet below top of ground.

(4) Cased to 33, Size 2

(5) Screen: Size 1/4, Length 6


(6) Were any formations sealed against pollution? seal in with plastic

yes, X no.

If YES depth of formation

Why

Drillers Remarks:

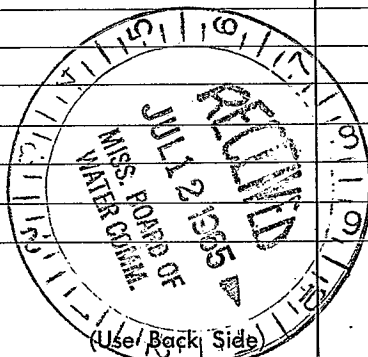

Well No.

Handwritten signature or mark