

Wayne

U 21

10-67

MISSISSIPPI
 BOARD OF WATER COMMISSIONERS
 416 North State Street
 Jackson, Mississippi 39201

WATER WELL DRILLERS LOG

Oct 3 1967 Rooter Drilling Co Wayne
 date well completed firm name county well located

LANDOWNER: J. H. Sullivan
Buckatuna, Miss
Okla Springs
 (mailing address)

WELL LOCATION:
 sec 9 T 7 N 3 R 5 E W1
1/2 miles east of Buckatuna
 (distance) (direction) (nearest town)


WELL PURPOSE: home
 (home, irrigation, municipal, industrial)

WELL COMPLETION DATA:

- (1) diameter (inches) 2"
- (2) total depth (feet) 123'
- (3) static water level (feet) 105' below above top of ground.
- (4) casing steel 1 1/4'
 (material) (depth)
2 If telescope see back.
 (size)
- (5) screen 5' 115'
 (length) (depth to top)
1" 8 slot S.S.
 (size) (material)
- (6) pump 1 1/2 6
 (HP) (yield gpm)
elec
 (type power)
- (7) electric log no
 (yes or no)
 (organization running log)
- (8) how well bottom plugged

description of formations encountered	from	to
red clay	0	15
red sand	15	40
thin rock		40
red chalk	40	47
blue chalk	47	78
sand + chalk	78	88
chalk	88	98
sandstone to fine	98	106
chalk	106	109
sandstone to fine at bottom	109	123
stagnant water still in fine sand		

DRILLERS REMARKS:

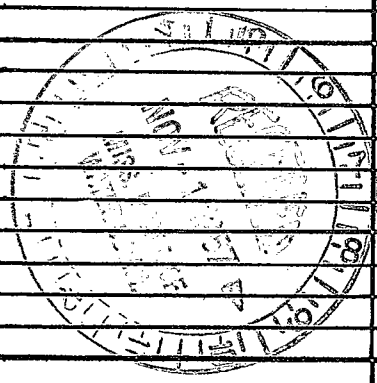

loc 33

