

WAYNE
 W 25
 3-68

MISSISSIPPI
 BOARD OF WATER COMMISSIONERS
 416 North State Street
 Jackson, Mississippi 39201

WATER WELL DRILLERS LOG

3-20 19 68 CARRS DRILLING SERVICE WAYNE
 date well completed firm name county well located

LANDOWNER: PERCY DYCESS
RT 1 BUCATUNNA MISS
 (mailing address)
 WELL LOCATION:
 sec 33 T A (N) R 5 E (W)
1 1/2 miles SE of BUCATUNNA
 (distance) (direction) (nearest town)


description of formations encountered	from	to
<u>Topsoil</u>	<u>0</u>	<u>2</u>
<u>BROWN CLAY</u>	<u>2</u>	<u>8</u>
<u>GRAY CLAY w/ PINK STREAKS</u>	<u>8</u>	<u>42</u>
<u>BLUE CLAY</u>	<u>42</u>	<u>52</u>
<u>YELLOW CLAY</u>	<u>52</u>	<u>58</u>
<u>FINE FINE WHITE SAND</u>	<u>58</u>	<u>60</u>
<u>YELLOW CLAY</u>	<u>60</u>	<u>79</u>
<u>Med coarse yellowish sh.</u>	<u>79</u>	<u>90</u>

WELL PURPOSE: Home
 (home, irrigation, municipal, industrial)

WELL COMPLETION DATA:
 (1) diameter (inches) 2"
 (2) total depth (feet) 90
 (3) static water level (feet) 53 ^{below} _{above} top of ground.
 (4) casing Galv, 86'
 (material) (depth)
 _____ if telescope see back.
 (size)
 (5) screen 5', 86'
 (length) (depth to top)
1 1/4, BRASS
 (size) (material)
 (6) pump 1/2 6
 (HP) (yield gpm)
Elect
 (type power)
 (7) electric log No
 (yes or no)


 (organization running log)
 (8) how well bottom plugged B.W.V.

DRILLERS REMARKS: Tip
Depth is 1' Above
Ground

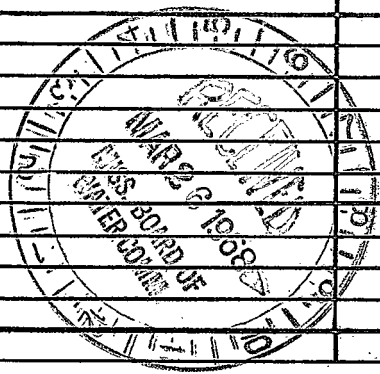

If well telescopes please sketch and show depths.

GROUND LEVEL

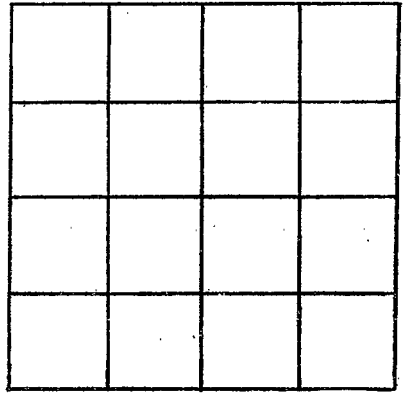

SECTION 7

Please indicate well location X.

ADDITIONAL INFORMATION

Developed well
at Rate of 12 gal
Per min Pump
apply 30 min

If more than one screen,
show locations of each on sketch.