

WAYNE  
U 26  
4-68

MISSISSIPPI  
BOARD OF WATER COMMISSIONERS  
416 North State Street  
Jackson, Mississippi 39201

WATER WELL DRILLERS LOG

4-1 1968 Carrs well service Wayne  
date well completed firm name county well located

LANDOWNER Mr. C.H. G. West

description of formations encountered	from	to
<u>Red sand</u>	<u>0</u>	<u>23</u>
<u>Cosser yellowish SD</u>	<u>23</u>	<u>34</u>


Brentwood Miss  
(mailing address)

④ WELL LOCATION:  
sec. 18 T. 7 N. R. 5 E. W  
2 miles North of Buc  
(distance) (direction) (nearest town)

WELL PURPOSE: Home  
(home, irrigation, municipal, industrial)


- WELL COMPLETION DATA:
- (1) diameter (inches) 1 1/4
  - (2) total depth (feet) 34
  - (3) static water level (feet) 19 ' below top of ground.
  - (4) casing None  
(material) (depth)  
\_\_\_\_\_ if telescope see back.  
(size)
  - (5) screen 3 , 27  
" (length) (depth to top)  
1/4 , Stainless steel  
(size) (material)
  - (6) pump 1/3 (HP) 5 (yield gpm)  
Elect  
(type power)
  - (7) electric log None  
(yes or no)  
\_\_\_\_\_  
(organization running log)
  - (8) how well bottom plugged Back  
marsh valve

DRILLERS REMARKS: well #1

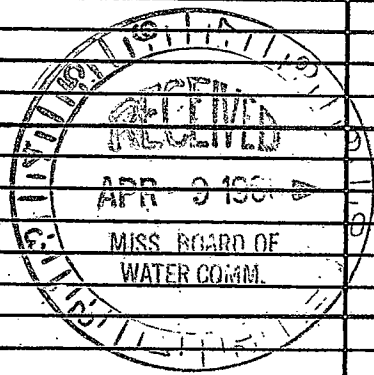

If well telescopes please sketch and show depths.

GROUND LEVEL

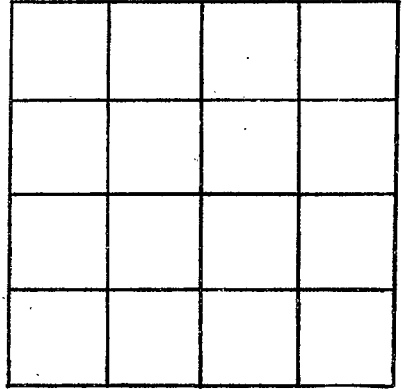

SECTION \_\_\_\_\_

Please indicate well location X.

ADDITIONAL INFORMATION

If more than one screen,  
show locations of each on sketch.