

WAYNE
 W 27
 4-68

MISSISSIPPI
 BOARD OF WATER COMMISSIONERS
 416 North State Street
 Jackson, Mississippi 39201

WATER WELL DRILLERS LOG

4-2 1968 *Carina well service Wayne*
 date well completed firm name county well located

LANDOWNER *M. C. H. C. Gilbert*

description of formations encountered	from	to
<i>Red sand</i>	<i>0</i>	<i>20</i>
<i>Coarse white sand, pebbles</i>	<i>20</i>	<i>30</i>
<i>gravel</i>		


BUCHTUNNER MISS
 (mailing address)

WELL LOCATION:
 sec. 18 T. 7 N R. 5 E
 2 miles NORTH of BUCHTUNNER
 (distance) (direction) (nearest town)

WELL PURPOSE: *Normal*
 (home, irrigation, municipal, industrial)

- WELL COMPLETION DATA:
- (1) diameter (inches) *1 1/4*
 - (2) total depth (feet) *29'*
 - (3) static water level (feet) *19'* below above top of ground.
 - (4) casing *None*
 (material) (depth)
 (size) If telescope see back.
 - (5) screen *30"* , *25 1/4"*
 (length) (depth to top)
1 1/4" , *B. BRASS*
 (size) (material)
 - (6) pump *1/2* , *6*
 (HP) (yield gpm)
Elect
 (type power)
 - (7) electric log *None*
 (yes or no)
 (organization running log)
 - (8) how well bottom plugged *Drive*
Point

DRILLERS REMARKS: *Walter J*

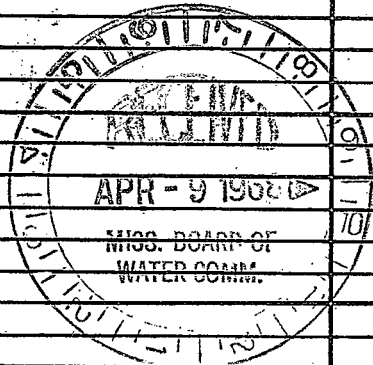

If well telescopes please sketch and show depths.

GROUND LEVEL

SECTION _____

Please indicate well location X.

ADDITIONAL INFORMATION

If more than one screen, show locations of each on sketch.