

Wayne  
 K 29  
 7-68

MISSISSIPPI CODED  
 BOARD OF WATER COMMISSIONERS  
 416 North State Street  
 Jackson, Mississippi 39201

WATER WELL DRILLERS LOG

7-27-68 date well completed  
 Roy W. West firm name  
 Wayne county well located

LANDOWNER: C. A. Borman  
 Bucatuna  
 Miss  
 (mailing address)


description of formations encountered	from	to
Clay	0	10
Sand	10	40

WELL LOCATION: NW 1/4 SE  
 sec. 30 T. 17 N R. 18 E  
 S W  
 0 miles 0 Bucatuna  
 (distance) (direction) (nearest town)

WELL PURPOSE: home  
 (home irrigation, municipal, industrial)

WELL COMPLETION DATA:

- (1) diameter (inches) 2 in
- (2) total depth (feet) 40
- (3) static water level (feet) 20 below above top of ground.
- (4) casing galv 35  
 (material) (depth)  
 (size) if telescope see back.
- (5) screen 5 1/2 35  
 (length) (depth to top)  
1/4 st steel  
 (size) (material)
- (6) pump 1/2 6  
 (HP) (yield gpm)  
REA  
 (type power)
- (7) electric log no  
 (yes or no)

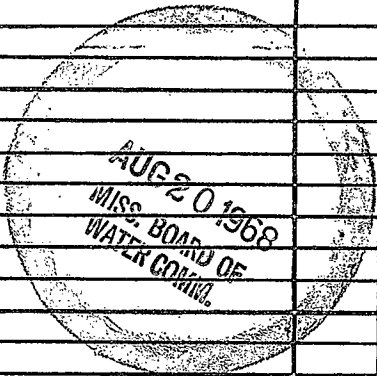


(organization running log)

(8) how well bottom plugged washed

DRILLERS REMARKS:

If well telescopes please sketch and show depths.

GROUND LEVEL

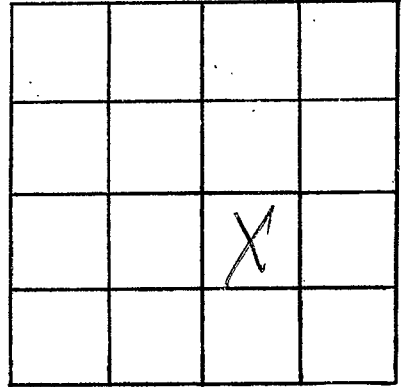

SECTION 30

Please indicate well location X.

ADDITIONAL INFORMATION

If more than one screen,  
show locations of each on sketch.