

**MISSISSIPPI
BOARD OF WATER COMMISSIONERS**
416 North State Street
Jackson, Mississippi 39201

66112

WATER WELL DRILLERS LOG

Wayne
U 30
2-69

2-13 1969 our water well Wayne
date well completed firm name county well located

LANDOWNER: W.B. Bradley
RT 1 Brucetown
Miss
(mailing address)

description of formations encountered	from	to
<u>PINK + GRAY CLAY</u>	<u>0</u>	<u>12</u>
<u>GRAYISH + YELLOW CLAY</u>	<u>12</u>	<u>17</u>
<u>FINE YELLOWISH TIGHT SD</u>	<u>17</u>	<u>21</u>
<u>BRITTLE GRAY + YELLOW CLAY</u>	<u>21</u>	<u>26</u>
<u>FINE GRAYISH SD</u>	<u>26</u>	<u>28</u>
<u>WHITE WET SANDY CLAY</u>	<u>28</u>	<u>33</u>
<u>BLUEISH + PINK CLAY</u>	<u>33</u>	<u>43</u>
<u>YELLOW + BLUEISH CLAY</u>	<u>43</u>	<u>53</u>
<u>VERY FINE CRISTAL SD</u>	<u>53</u>	<u>61</u>
<u>YELLOW CLAY</u>	<u>61</u>	<u>64</u>
<u>DARK PINK + GRAY CLAY</u>	<u>64</u>	<u>68</u>
<u>WET BLUEISH CLAY</u>	<u>68</u>	<u>102</u>
<u>DARK GRAY CLAY</u>	<u>102</u>	<u>116</u>
<u>1" DARK GRAY</u>		
<u>ROCKY COARSE SD</u>		
<u>W/ GRAVEL</u>	<u>116</u>	<u>135</u>

WELL LOCATION:
sec. 4 T. 7 N. R. 5 E. W
5 1/4 miles NE of Brucetown
(distance) (direction) (nearest town)

WELL PURPOSE: Home
(home, irrigation, municipal, industrial)

WELL COMPLETION DATA:

(1) diameter (inches) 2" X 4"

(2) total depth (feet) 135

(3) static water level (feet) 68 below top of ground. above

(4) casing Plastic 126
(material) (depth)

(size) if telescope see back.

(5) screen 8 126
(length) (depth to top)

2 plastic
(size) (material)

(6) pump 1 11
(HP) (yield gpm)

Elect
(type power)

(7) electric log No
(yes or no)

(organization running log)

(8) how well bottom plugged 2" B.W.V
w/ 1" L.H.


DRILLERS REMARKS: Set set
@ 100' w/ 2 packers
8 screens (10 S/10 T)

MAR 4 1969

MISS. BD. OF
WATER COMMISSIONERS

If well telescopes please sketch and show depths.

GROUND LEVEL

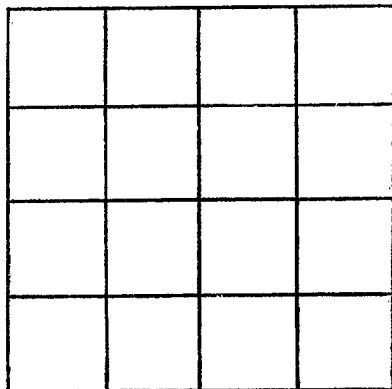

SECTION _____

Please indicate well location X.

ADDITIONAL INFORMATION

If more than one screen, show locations of each on sketch.